


PENNAGARAM G1

(MADAM SUMP TO MANGARAI MBR)

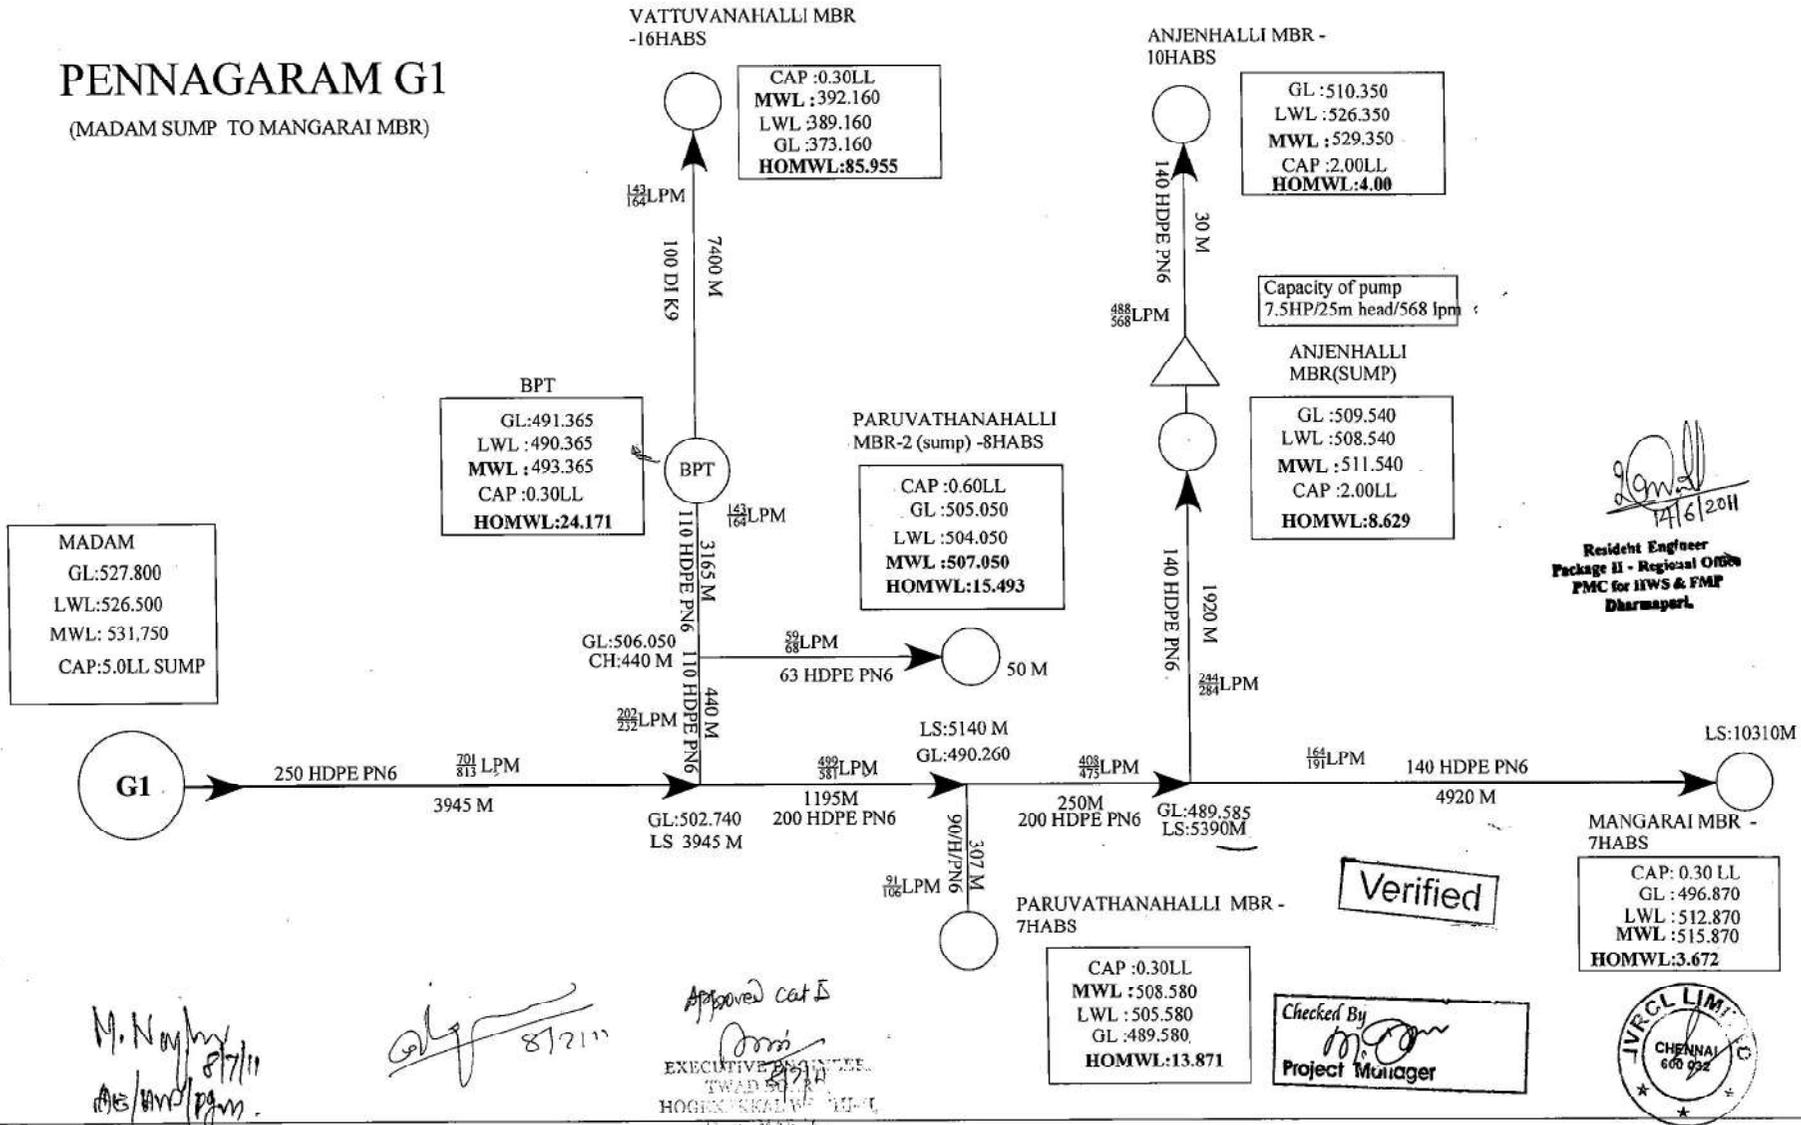

[Signature]
 Resident Engineer
 Package II - Regional Office
 PMC for HWS & FMP
 Dharmapuri

Verified

Checked By
[Signature]
 Project Manager



M. Nayana
 27/11/11
 AS/AMP/PGM

[Signature]
 8/12/11

Approved cat B
[Signature]
 EXECUTIVE ENGINEER
 TWARD
 HOBBENKAL
 D. S. S. S. S.

PENNAGARAM G2 (A)

(MADAM SUMP TO KALAPPAMPADI BPT - SUMP)

ANAIKALLNUR(E)
GL: 483.130
LWL:489.130
MWL: 491.290
CAP: 30 KL

MADAM
GL:527.800
LWL:526.500
MWL: 531.750
CAP:5.0LL SUMP



KARAIYAMPATTY(E)
GL: 482.830
MWL:491.330
CAP: 30 KL
HOMWL:30.148

KOTTAVUR(E)
GL:482.295
MWL:490.795
CAP:30 KL
HOMWL:29.055


MOTTUPATTY(E)
GL:482.180
LWL:489.680
MWL:492.680
CAP: 60 KL
HOMWL:19.136

MOTTUPATTY(E)
GL:476.700
LWL:482.700
MWL: 484.700
CAP:10 KL
HOMWL:29.436

MANJANAICKENHALLI MBR -12HABS
GL :470.930
LWL :486.930
MWL :489.930
CAP :0.60 LL
HOMWL:28.418

KALAPPAMPADI MBR-6HABS
GL :480.550
LWL :496.550
MWL :499.550
CAP :0.30 LL
HOMWL:7.948

KALAPPAMPADI BPT (SUMP)
GL :430.155
LWL :429.155
MWL : 432.155
CAP :1.50 LL
HOMWL:73.619

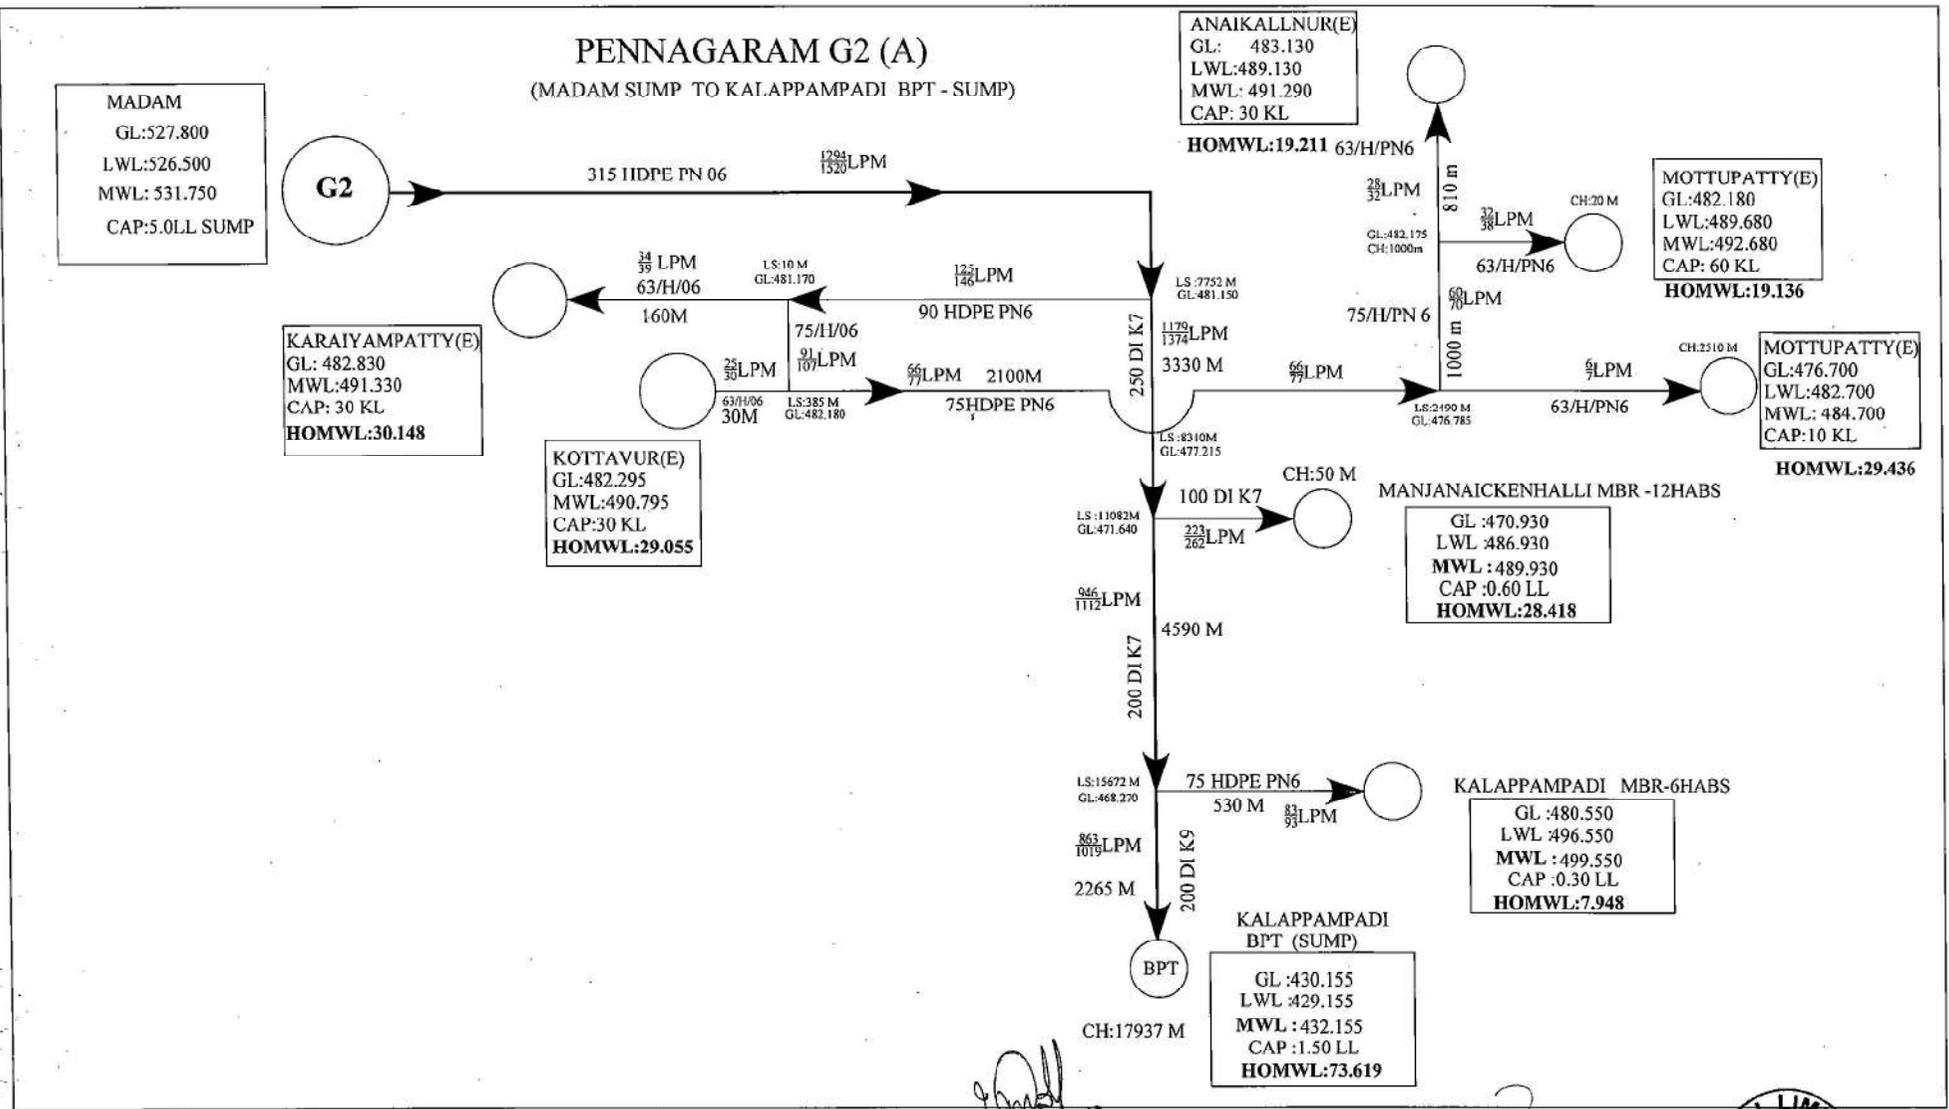

Handwritten signature and date
14/6/2011

Handwritten signature and date
14/6/2011

Handwritten signature
14/6/2011
Resident Engineer
Package II - Regional Office
PMC for IWS & FMP
Dharmapuri


00031

Handwritten signature
EXECUTIVE ENGINEER,
TWAD BOARD,
HOGENAKKAL WS PIU-II,
DHARMAPURI



PENNAGARAM G2 (B)

(KALAPPAMPADI BPT - SUMP TO MANJARAHALLI - SUMP)

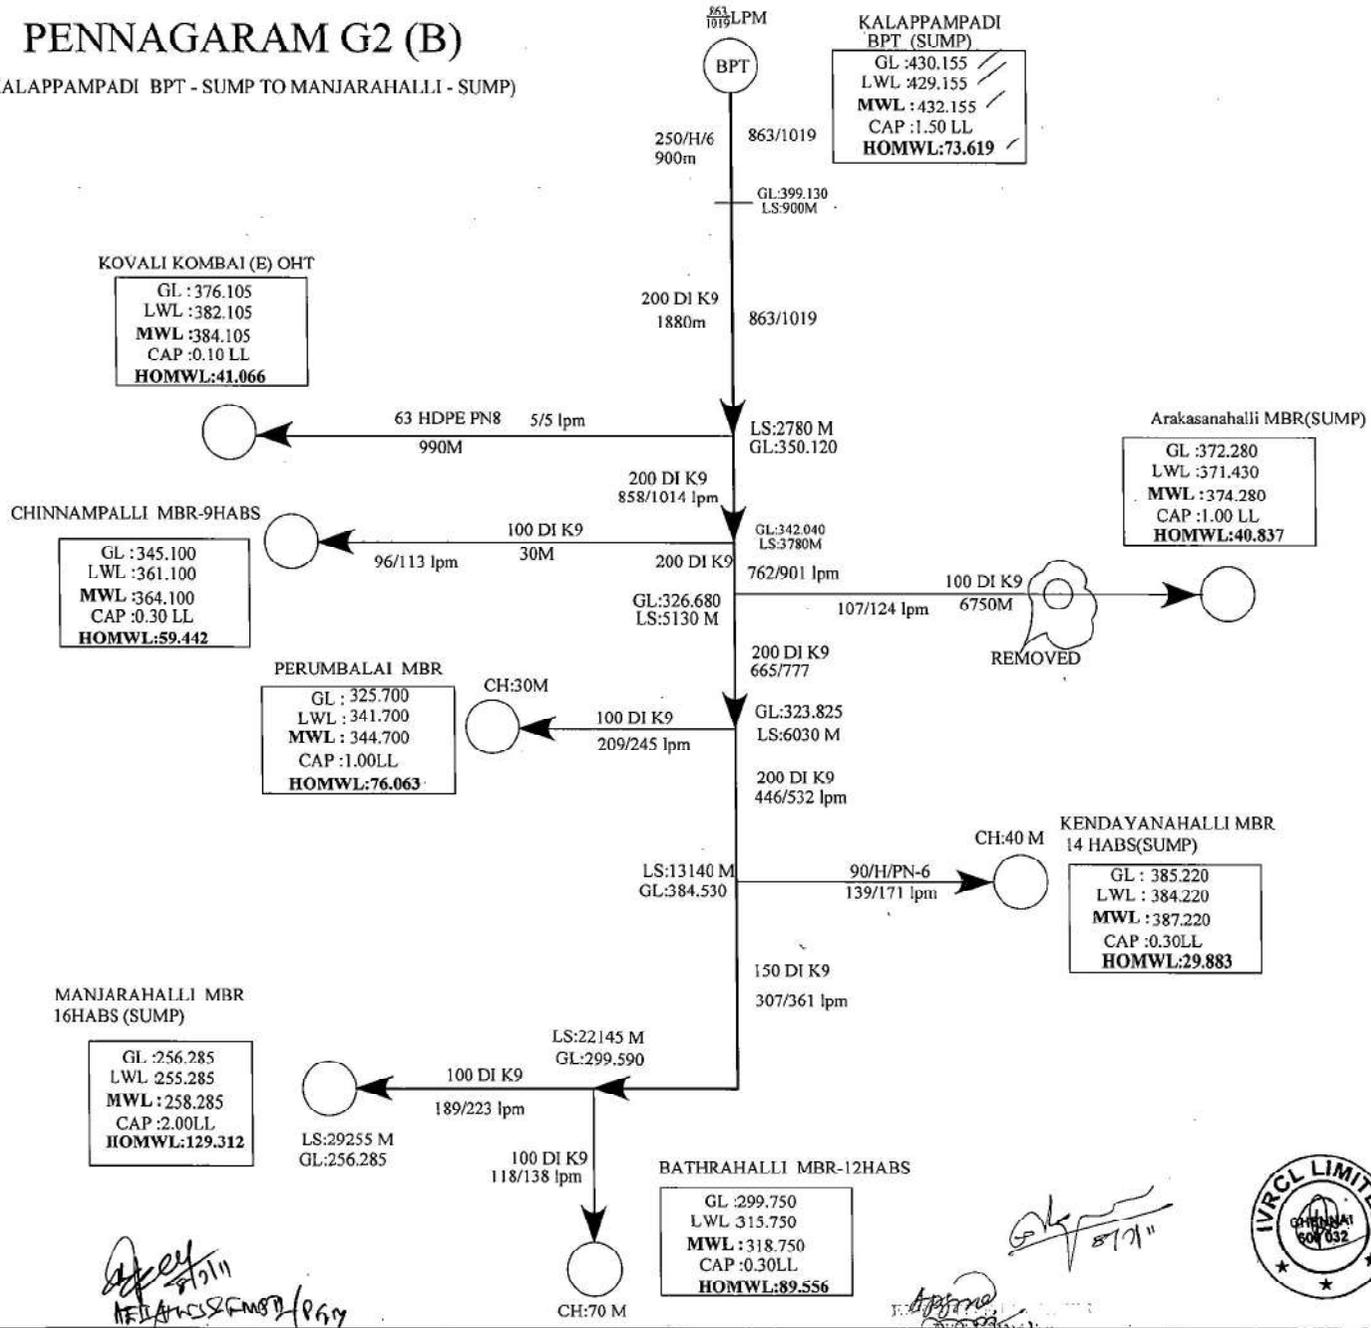


[Signature]
 14/6/2011
 Resident Engineer
 Package II - Regional Office
 PMC for IIWS & FMP
 Daarmapark



[Signature]
 14/6/2011

PENNAGARAM G3 (A)

(MADAM SUMP TO THONNAGUTLAHALLI BPT - SUMP)

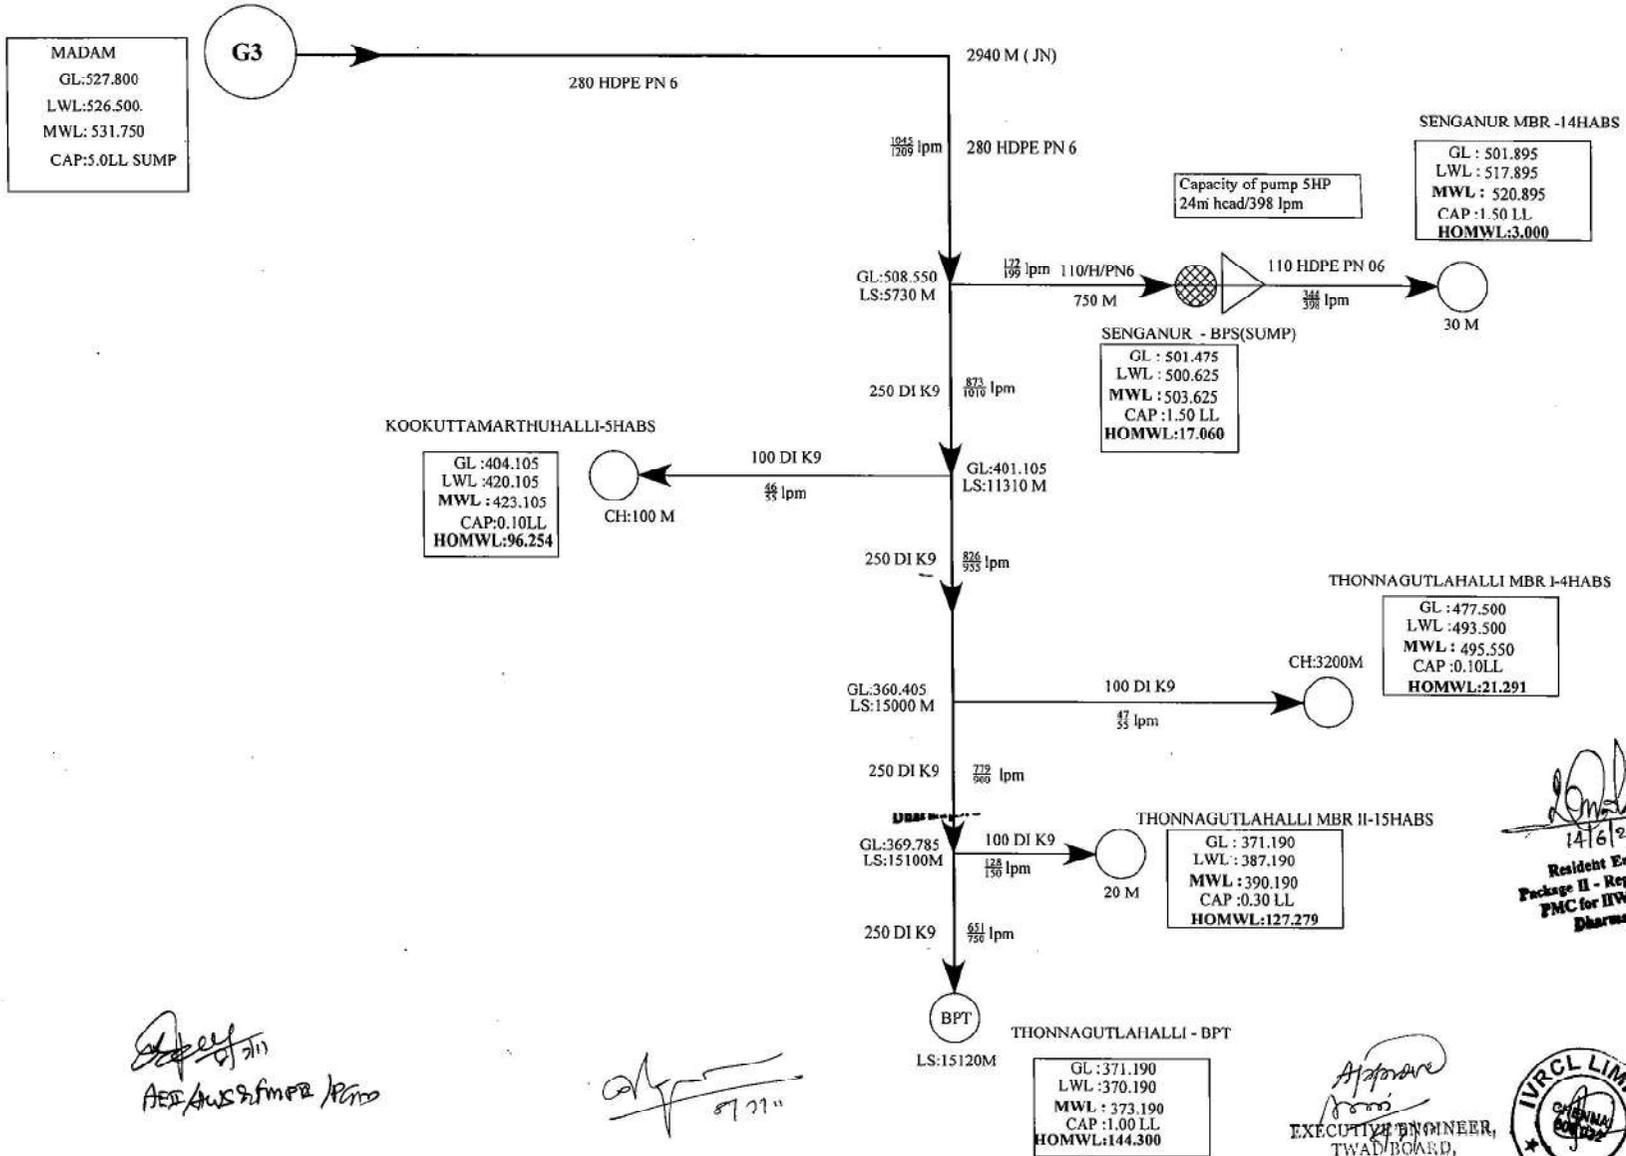

[Signature]
14/6/2011
Resident Engineer
Package II - Regional Office
FMC for IWS & FMP
Dharmapuri

[Signature]
14/6/2011
Asst. Engineer

[Signature]
14/6/2011

[Signature]
EXECUTIVE ENGINEER,
TWARD BOARD,
HOENAKKAL WS PIU-II,
DHARMAPURI

IVRCL LIMITED

THONNAGUTLAHALLI - BPT

GL : 371.190
 LWL : 370.190
 MWL : 373.190
 CAP : 1.00 LL
 HOMWL : 144.300

PENNAGARAM G3 (B)

(THONNAGUTLAHALLI BPT - SUMP TO NAGAMARAI - I MBR)

RAMAKONDAHALLI (SUMP)

GL : 343.370
 LWL : 342.370
 MWL : 345.370
 CAP : 0.30 LL
 HOMWL : 11.478

NAGAMARAI MBR II-5HABS
 LS:5050 m


GL : 271.925
 LWL : 287.925
 MWL : 290.925
 CAP : 0.10LL
 HOMWL : 66.294

SUNJALNATHAM MBR - 12HABS

GL : 318.320
 LWL : 334.320
 MWL : 337.320
 CAP : 0.60 LL
 HOMWL : 12.865

CH:21158 M
 NAGAMARAI MBR I-20HABS

GL : 267.355
 LWL : 283.355
 MWL : 286.355
 CAP : 0.60 LL
 HOMWL : 40.927

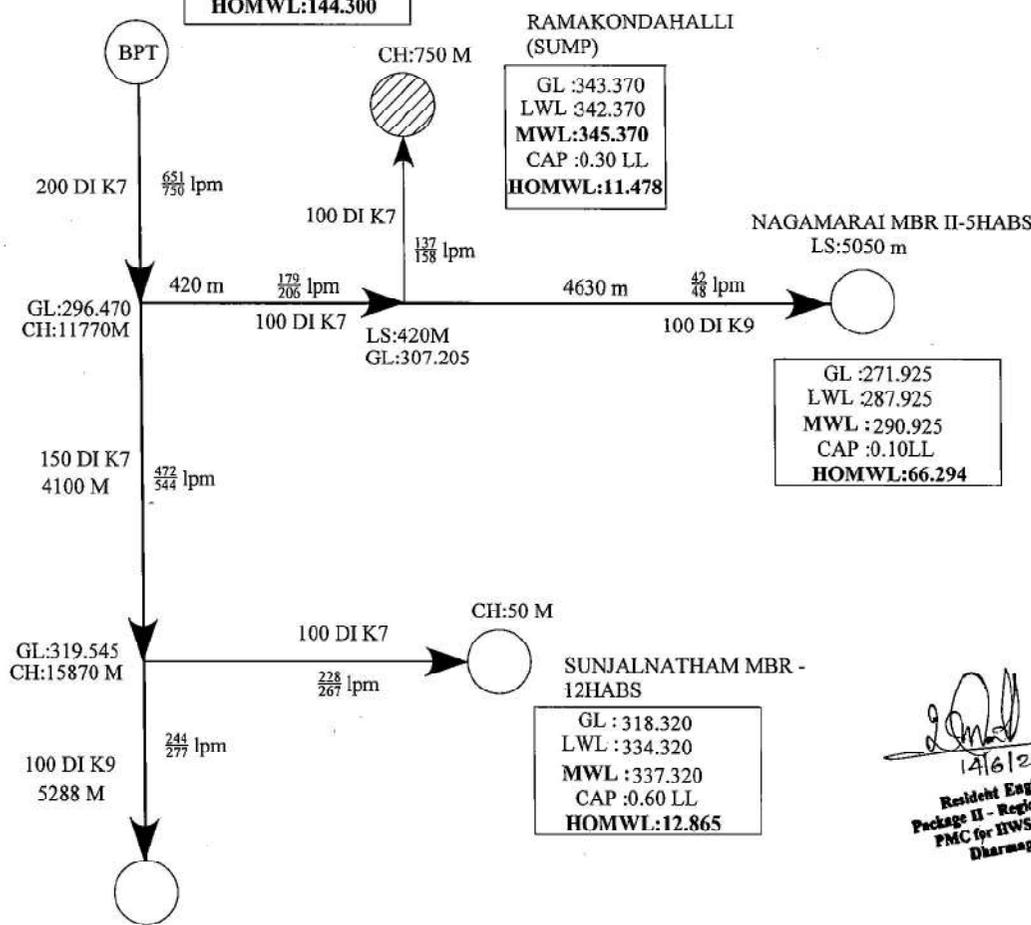

[Signature]
 14/6/2011
 Resident Engineer
 Package II - Regional Office
 PMC for IWS & FMP
 Dharmapuri.

[Signature]
 08/7/11
 AED/HWS & FMP/RRM


[Signature]
 EXECUTIVE ENGINEER,
 TWAD BOARD,
 HOGENAKKAL WS PIU-II,
 DHARMAPURI.



[Handwritten signature]
 08/7/11

PENNAGARAM(P1)

(MADAM SUMP TO KOOHPADI MBR)

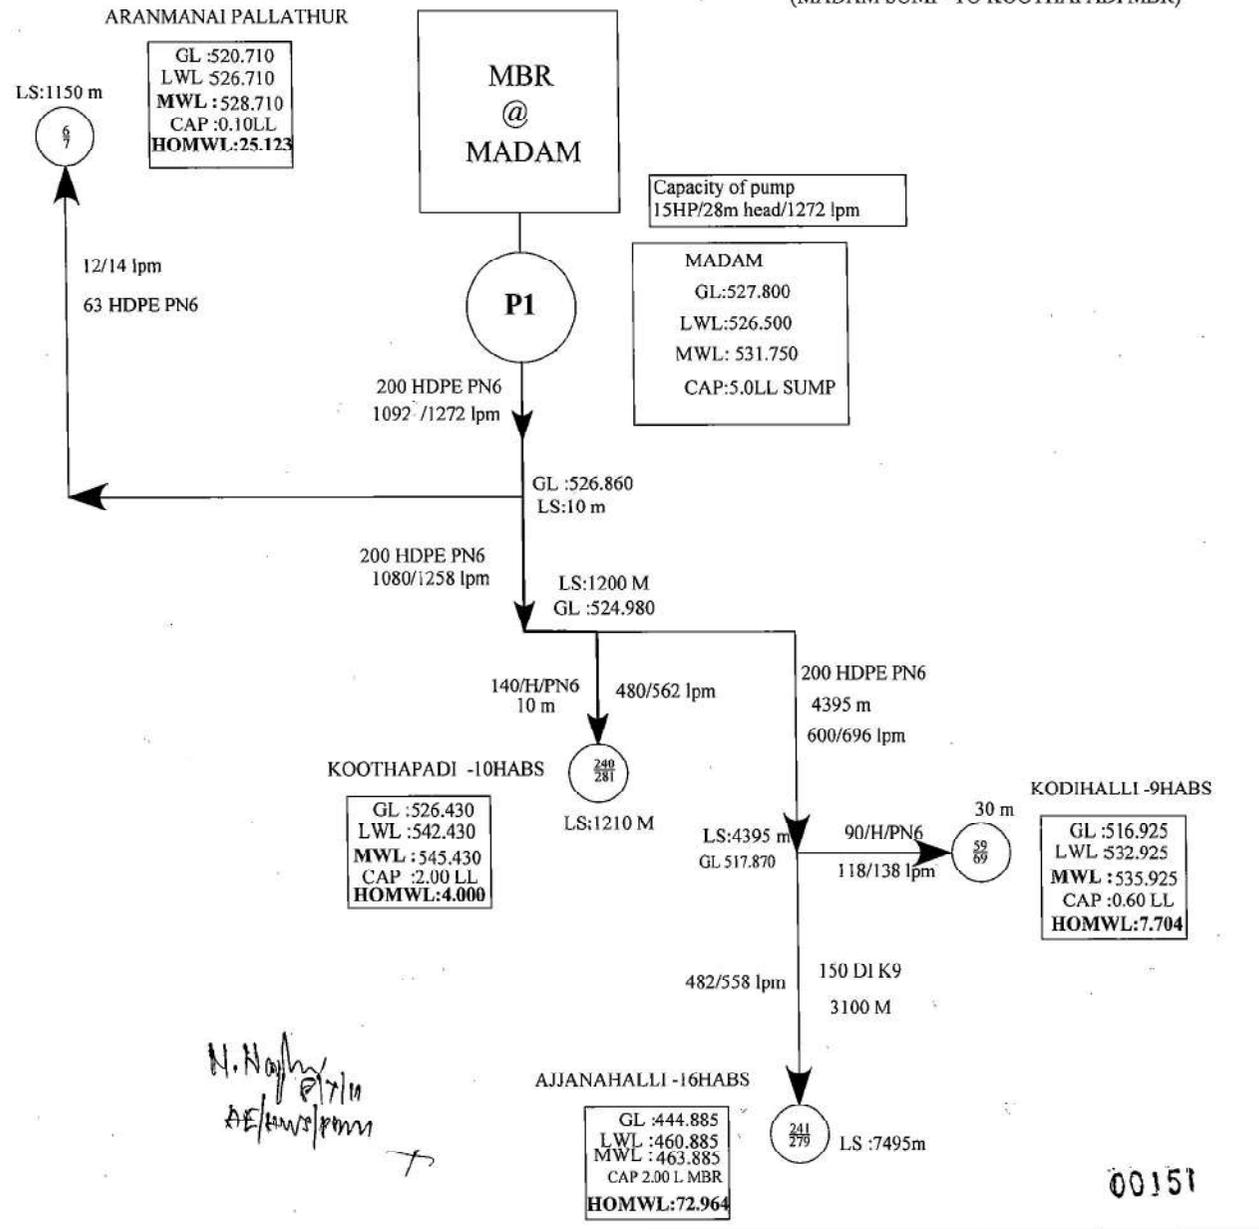

Handwritten signature

Handwritten signature
14/6/2011
Resident Engineer
Package II - Regional Office
PMC for HWS & FMP
Dharmapuri.

Approved
Handwritten signature
EXECUTIVE MEMBER,
TWAD BOARD,
HOENAKKAL WS PIU-II,
DHARMAPURI.




N. Nagesh
AE/HWS/PMC

00151


00151 00147

KONANGIHALLI (NALLAMPALLI UNION)

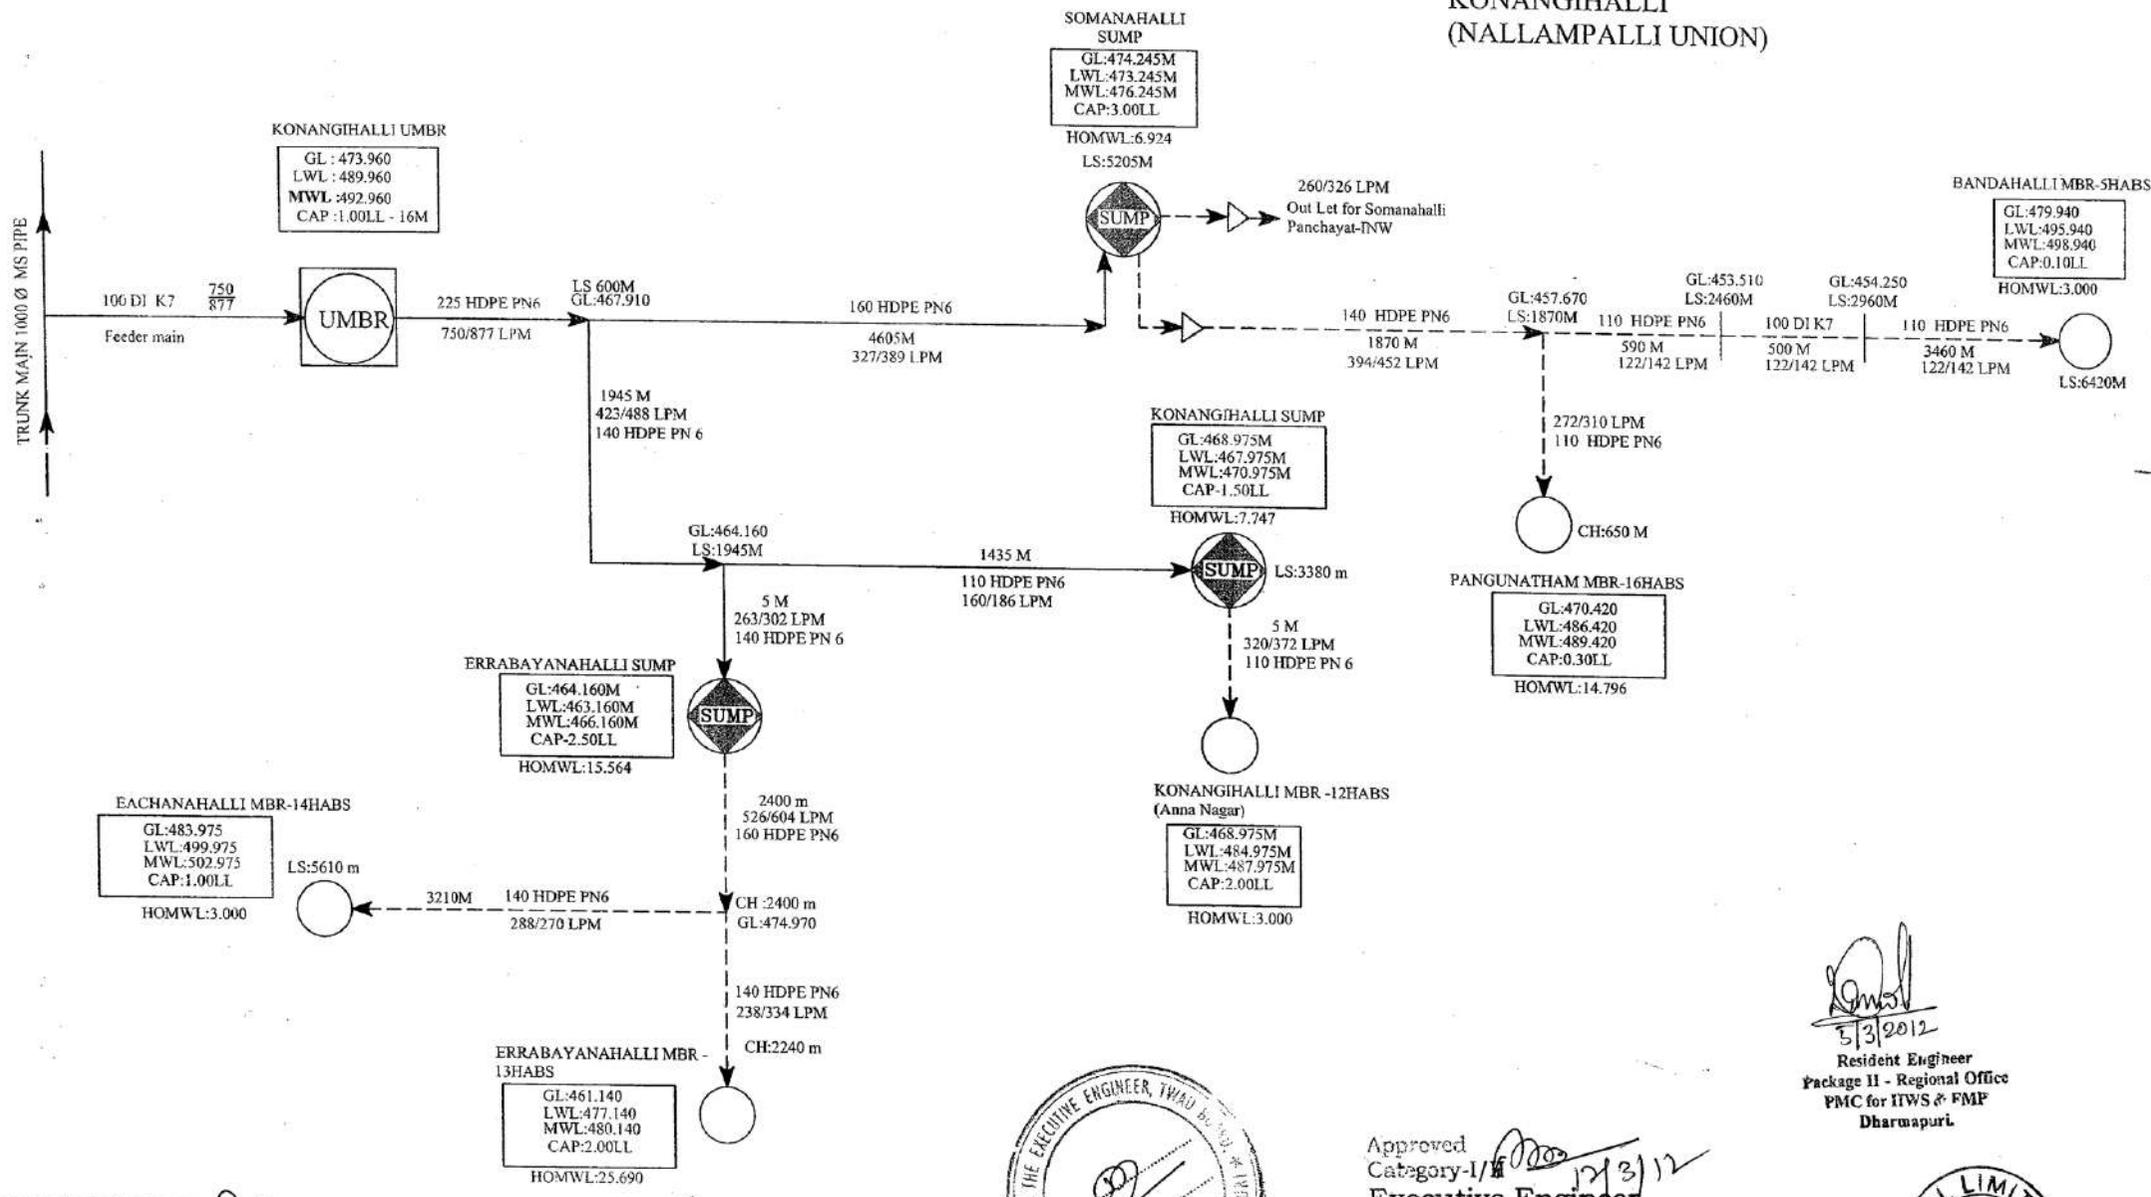

Handwritten signature
AR/HWS/PM

Handwritten signature
12/3/12
Assistant Executive Engineer
TAWD Board, HWS & FMP, PIU II
Pennagaram Sub Division,
Pennagaram, Dharmapuri District.

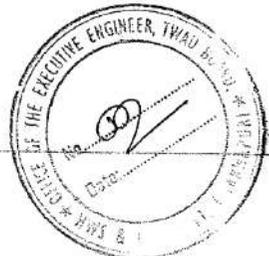


Approved
Category-I/*Handwritten signature*
12/3/12
Executive Engineer,
TAWD Board, HWS & FMP, PIU-II,
Dharmapuri.


Handwritten signature
5/3/2012
Resident Engineer
Package II - Regional Office
PMC for ITWS & FMP
Dharmapuri.




Dharmapuri - ATHAGAPADI - ITM FLOW DIAGRAM

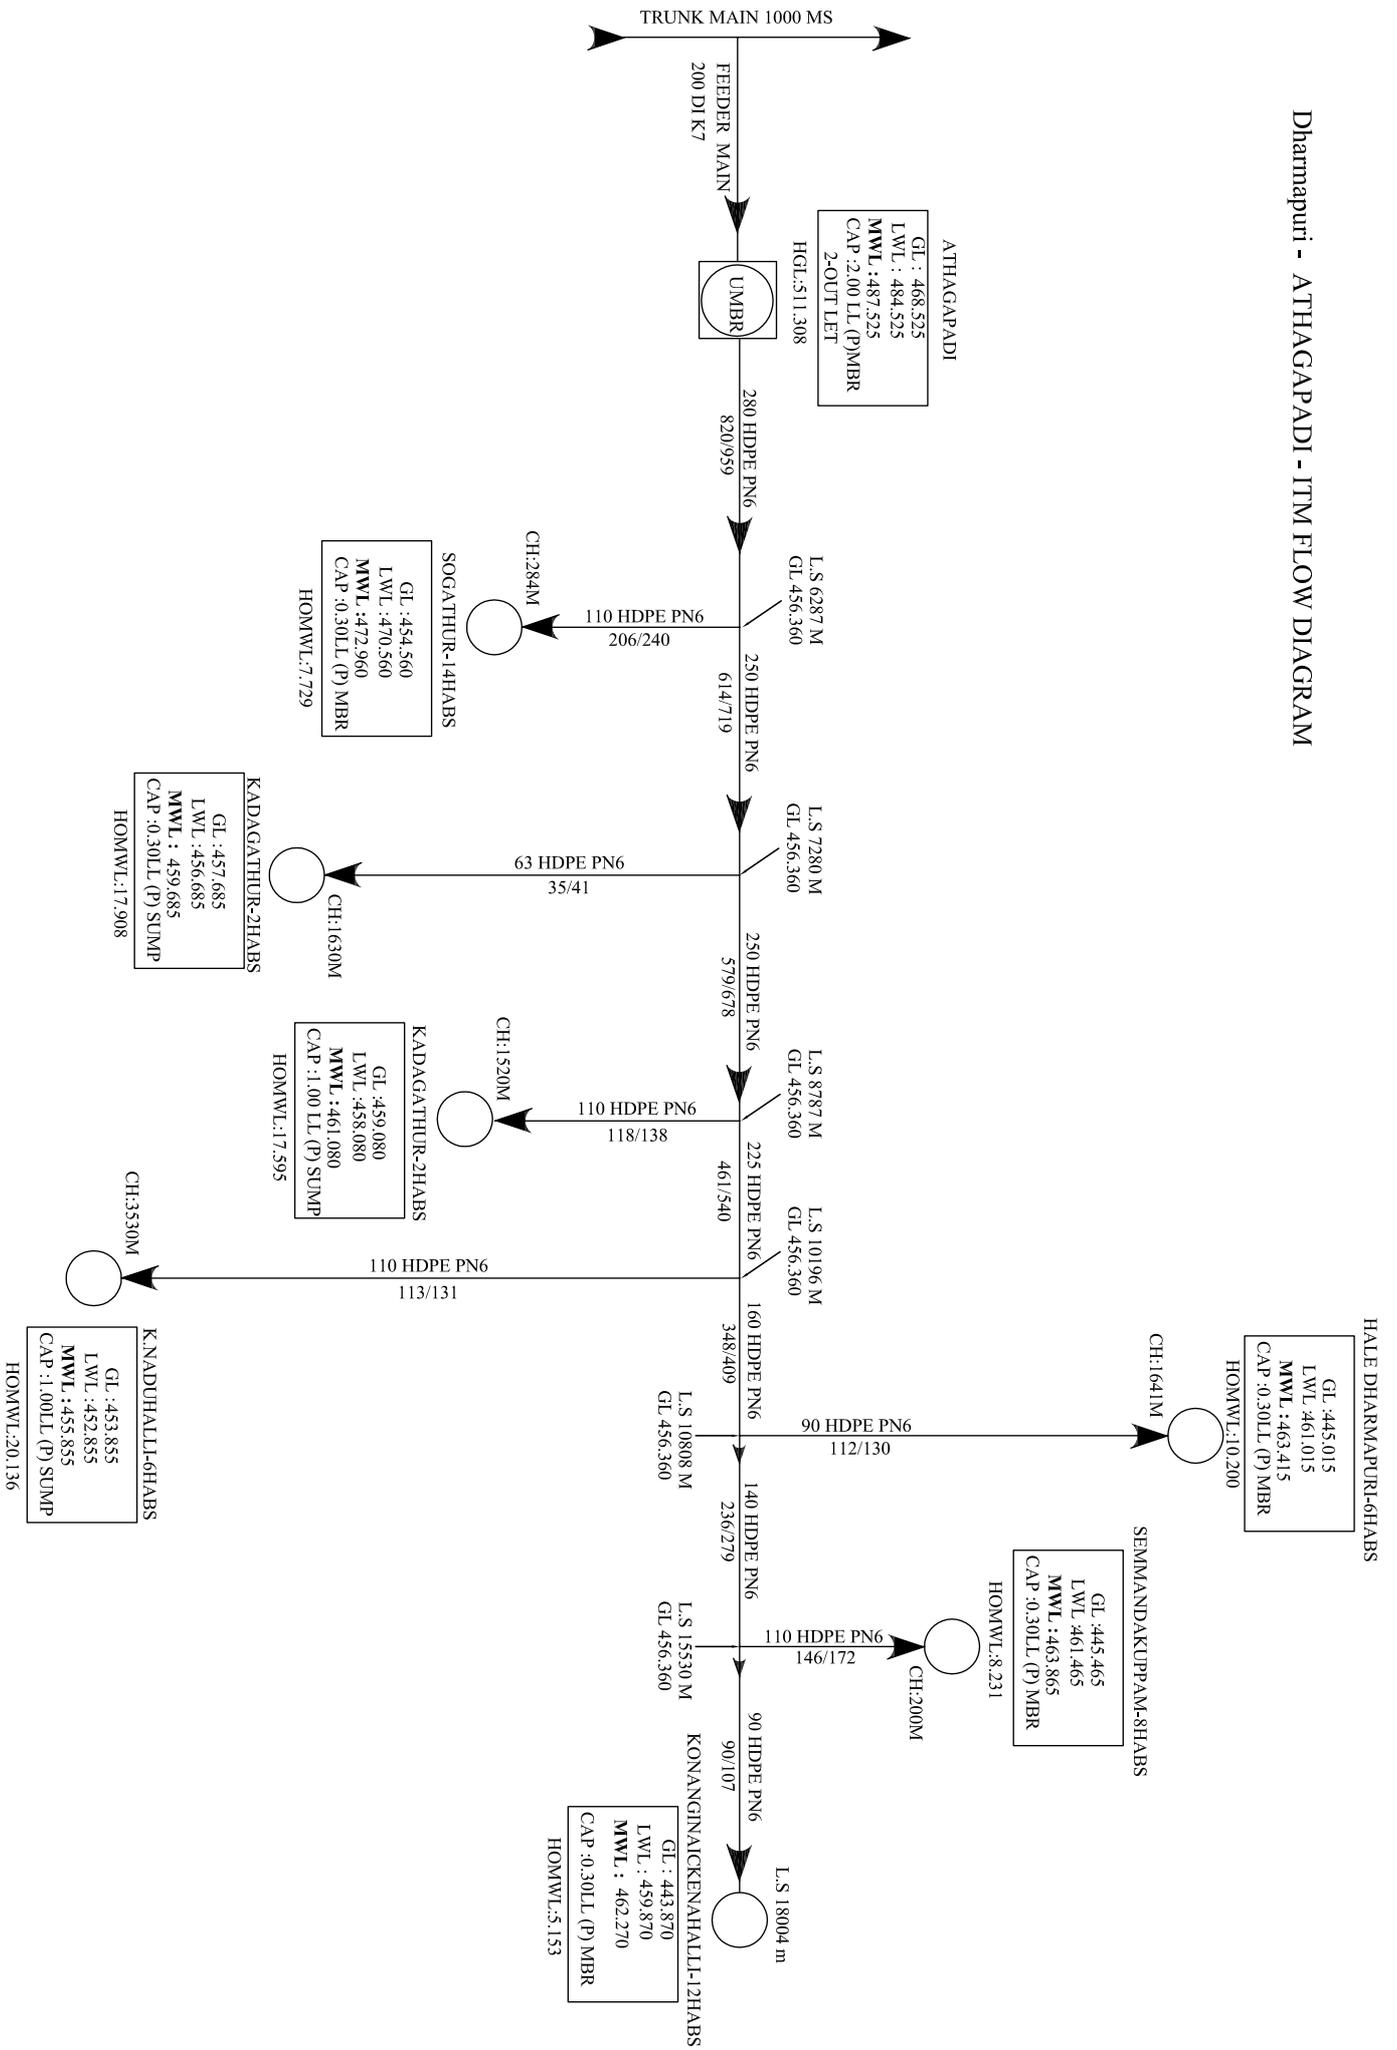


DHARMAPURI UNION - ITM

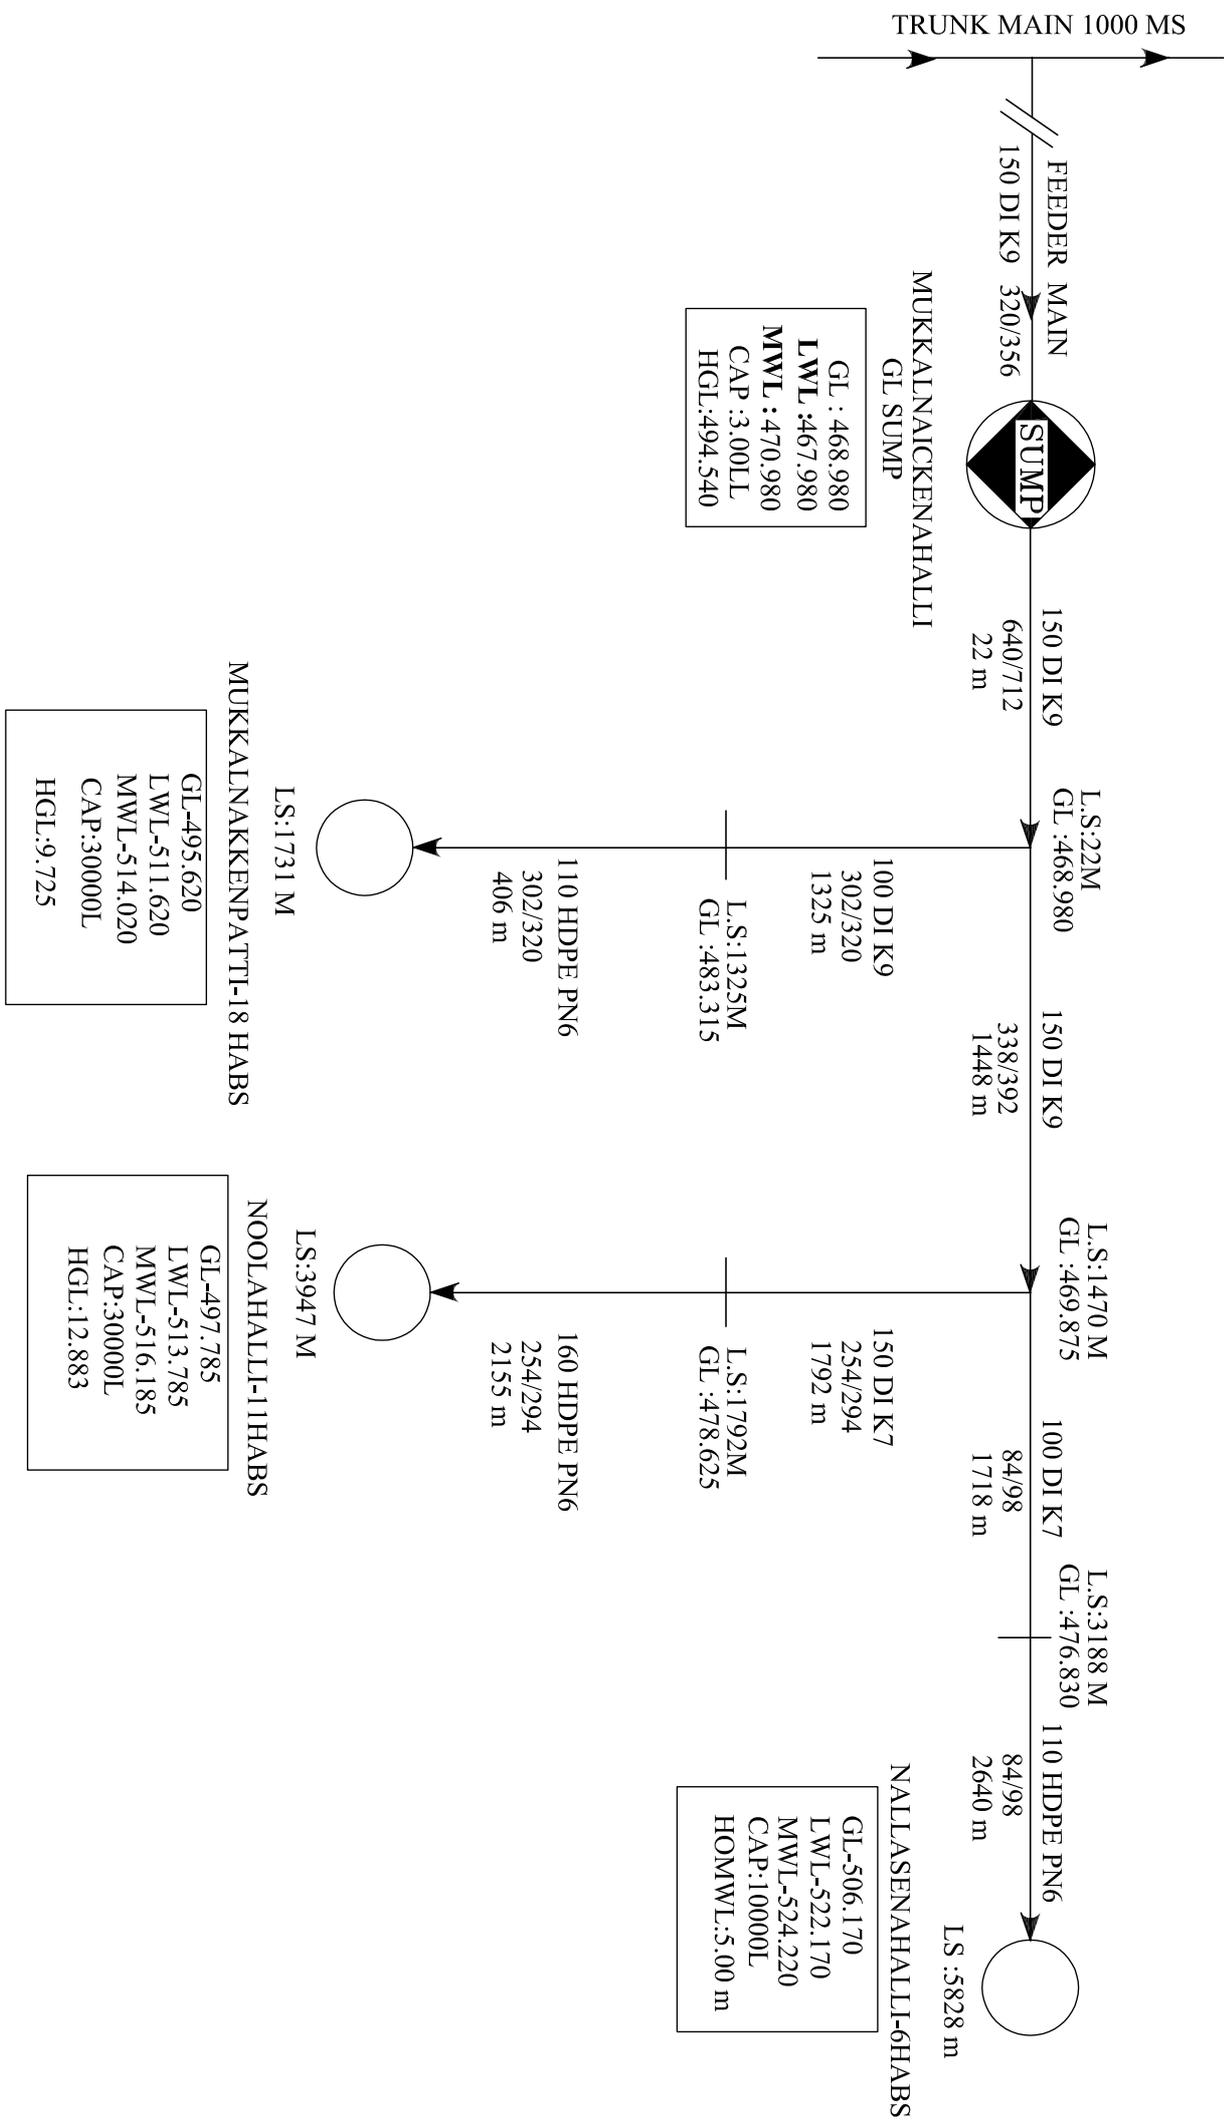


DHARMAPURI UNION - KUPPUR ITM

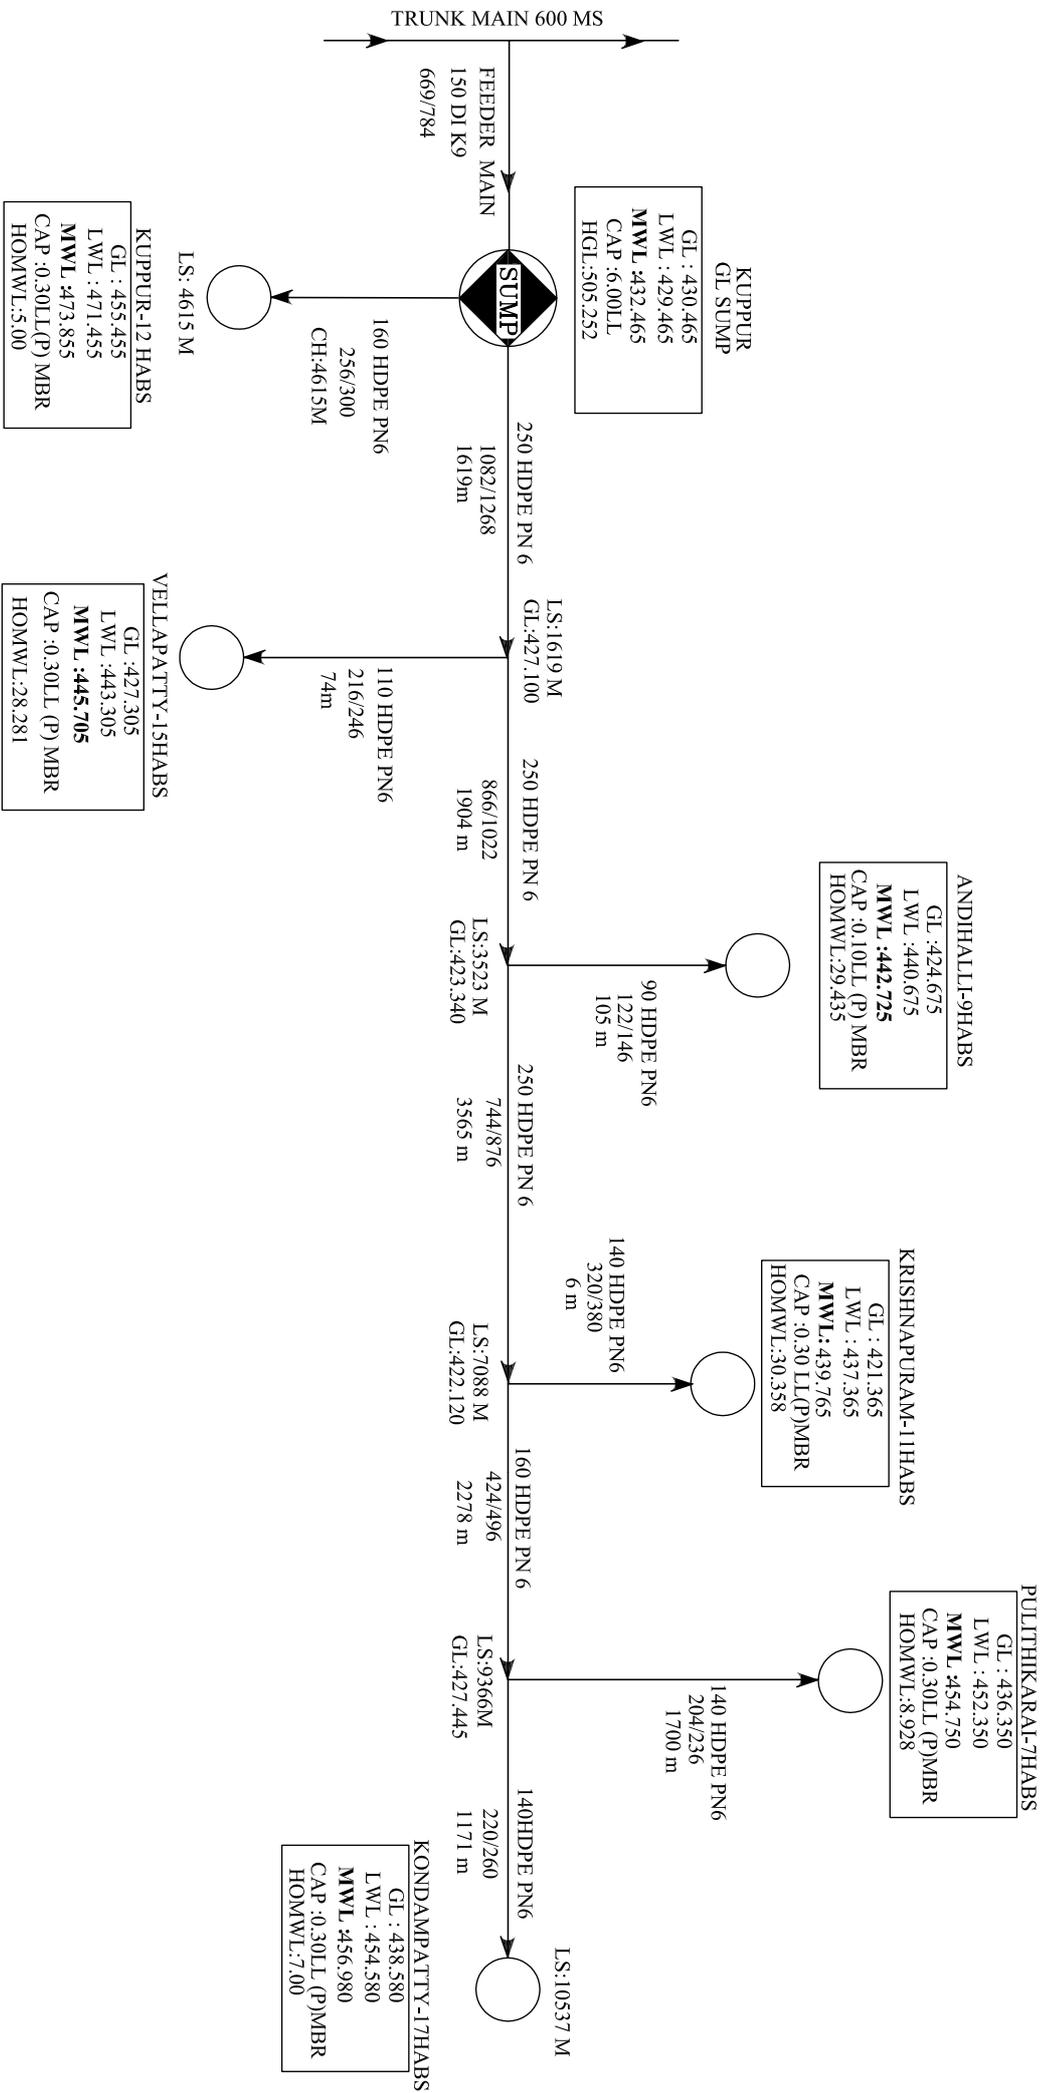

AS LAID FLOW DIAGRAM INTERNAL TRANSMISSION MATHUR UNION -ITM UMBR to MBR

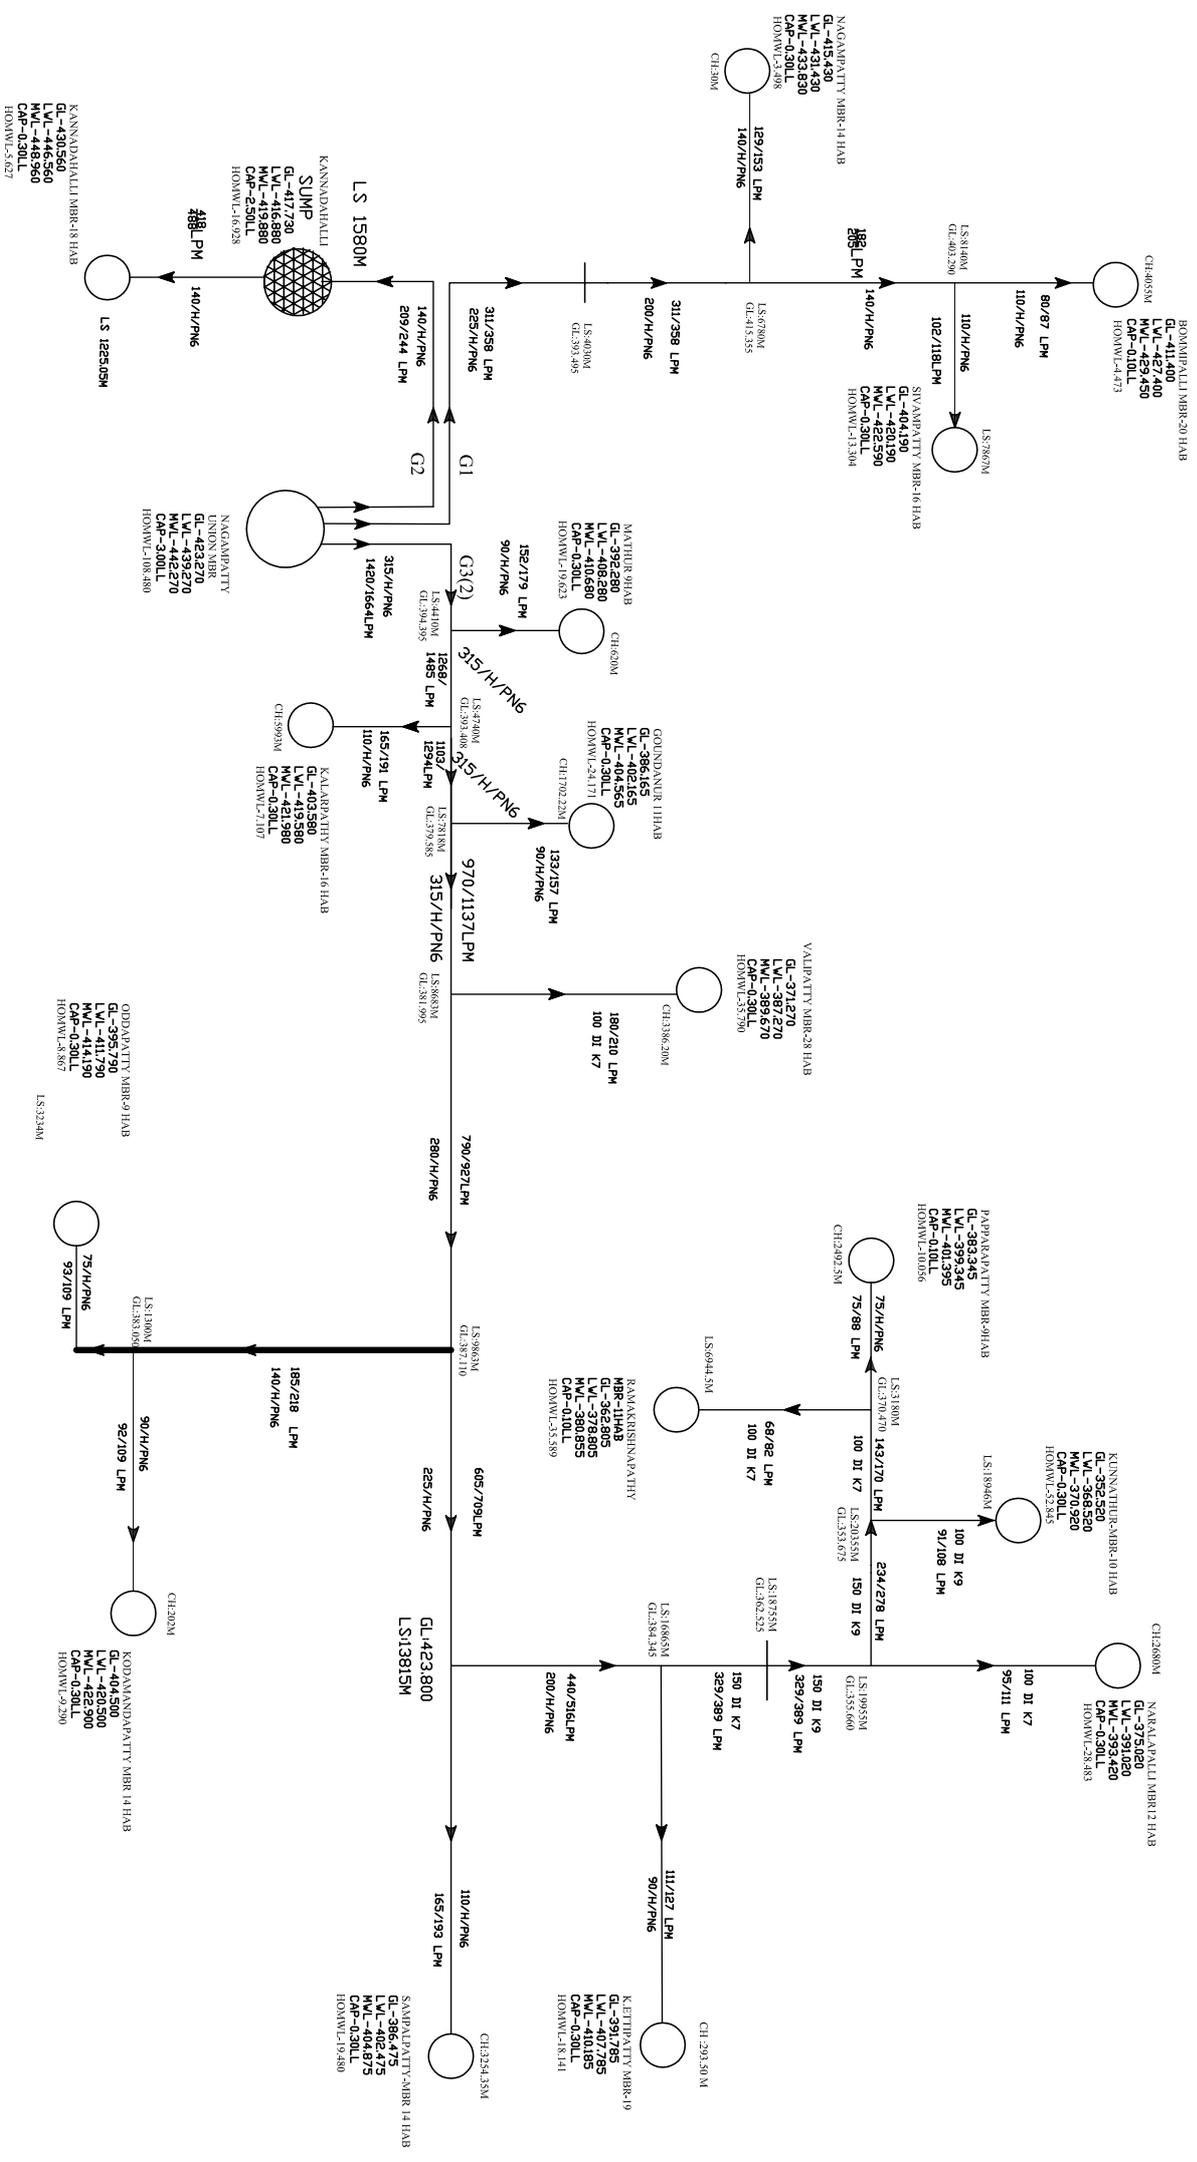

As Laid Flow Diagram For Internal Transmission Main ITM-Uthangarai union Outlet-I (UMBR to MBR)

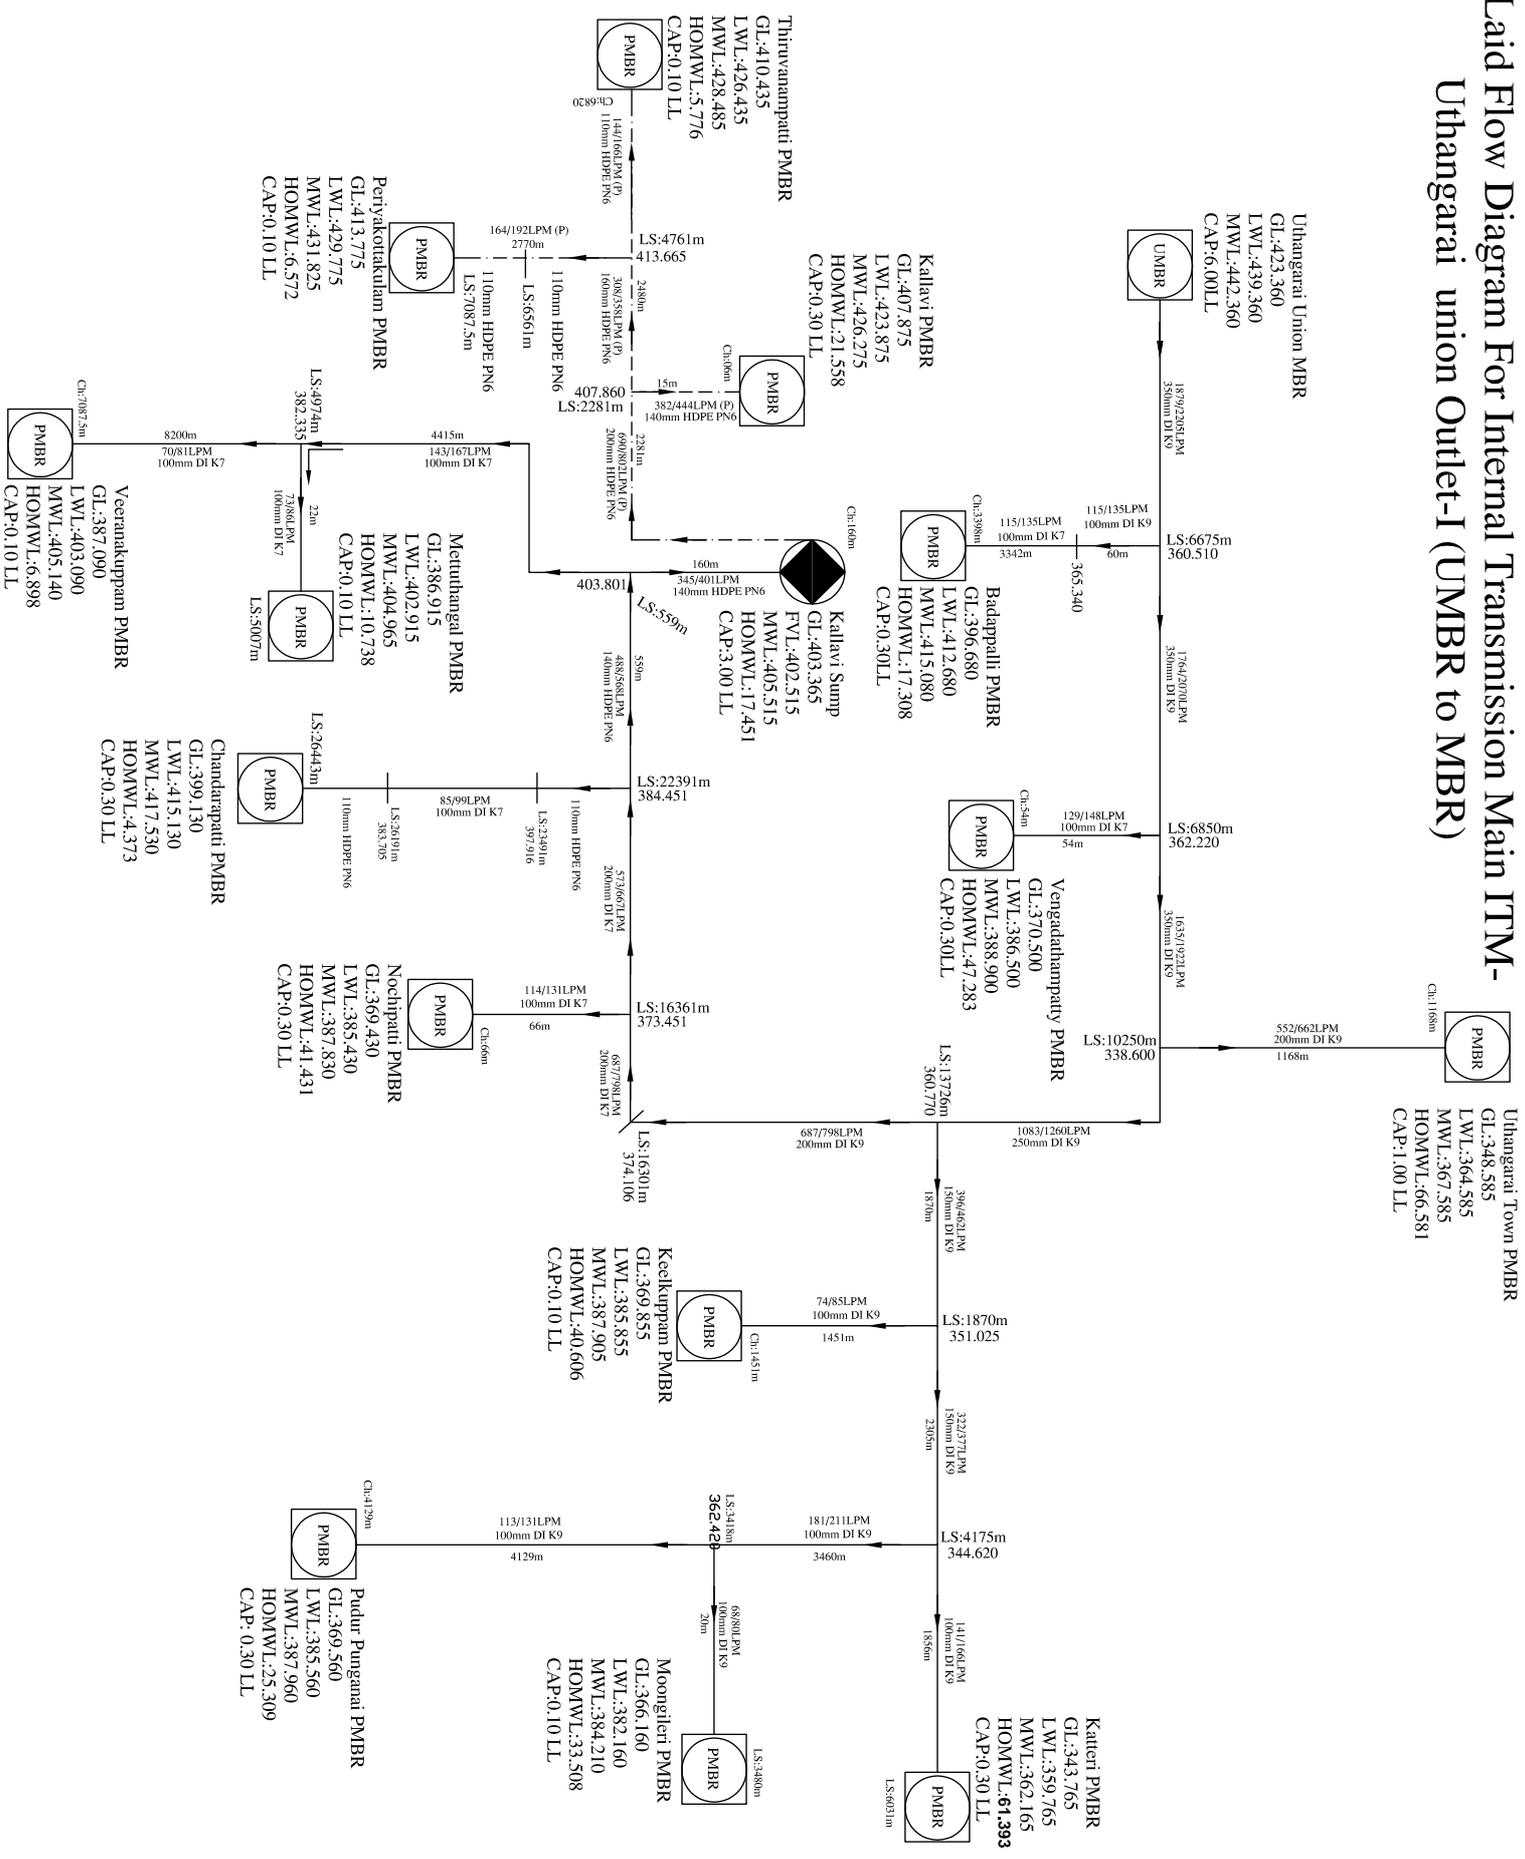

Uthangarai Town PMBR
 GL:348.585
 LWL:364.585
 MWL:367.585
 HOMWL:66.581
 CAP:1.00 LL

Uthangarai Union MBR
 GL:423.360
 LWL:439.360
 MWL:442.360
 CAP:6.00 LL

Kallavi PMBR
 GL:407.875
 LWL:423.875
 MWL:426.275
 HOMWL:21.558
 CAP:0.30 LL

Badappalli PMBR
 GL:396.680
 LWL:412.680
 MWL:415.080
 HOMWL:17.308
 CAP:0.30 LL

Kallavi Sump
 GL:403.365
 FVL:402.515
 MWL:405.515
 HOMWL:17.451
 CAP:3.00 LL

Vengadathampatty PMBR
 GL:370.500
 LWL:386.500
 MWL:388.900
 HOMWL:47.283
 CAP:0.30 LL

Keelkuppan PMBR
 GL:369.855
 LWL:385.855
 MWL:387.905
 HOMWL:40.606
 CAP:0.10 LL

Moongilteni PMBR
 GL:366.160
 LWL:382.160
 MWL:384.210
 HOMWL:33.508
 CAP:0.10 LL

Pudur Punganai PMBR
 GL:369.560
 LWL:385.560
 MWL:387.960
 HOMWL:25.309
 CAP:0.30 LL

Petyakottakulam PMBR
 GL:413.775
 LWL:429.775
 MWL:431.825
 HOMWL:6.572
 CAP:0.10 LL

Metuthangal PMBR
 GL:386.915
 LWL:402.915
 MWL:404.965
 HOMWL:10.738
 CAP:0.10 LL


Veeranakuppan PMBR
 GL:387.090
 LWL:403.090
 MWL:405.140
 HOMWL:6.898
 CAP:0.10 LL

Chandarapatti PMBR
 GL:399.130
 LWL:415.130
 MWL:417.530
 HOMWL:4.373
 CAP:0.30 LL


Nochpratti PMBR
 GL:369.430
 LWL:385.430
 MWL:387.830
 HOMWL:41.431
 CAP:0.30 LL


Thiruvannampatti PMBR
 GL:410.435
 LWL:426.435
 MWL:428.485
 HOMWL:5.776
 CAP:0.10 LL

As Laid Flow Diagram For Internal Transmission Main ITM- Uthangarai union Outlet-II (UMBR to MBR)

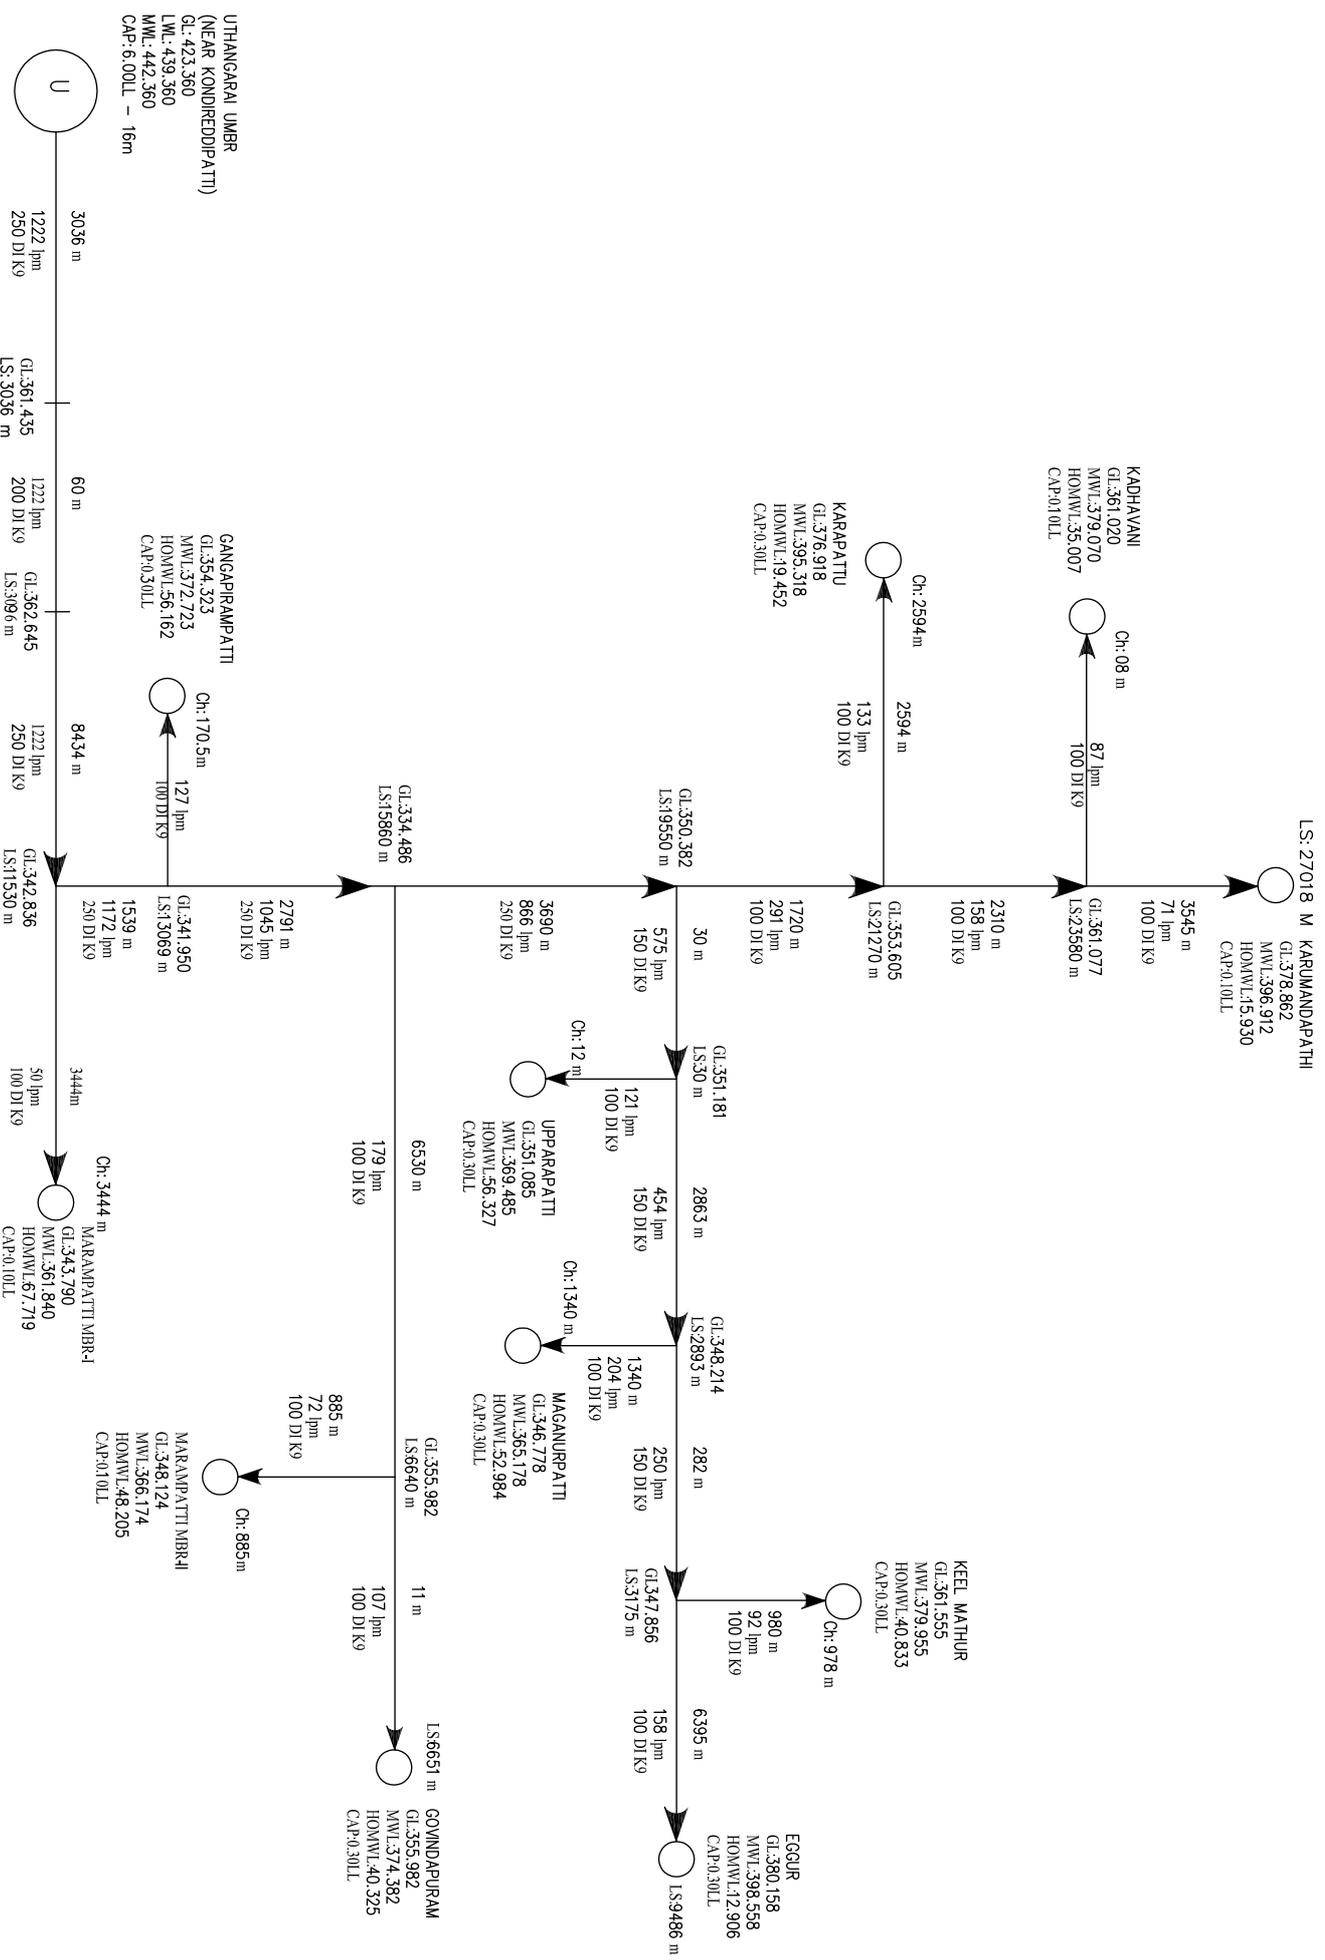

As Laid Flow Diagram For Internal Transmission Main ITM - Uthangarai union Outlet-III (UMBR to MBR)

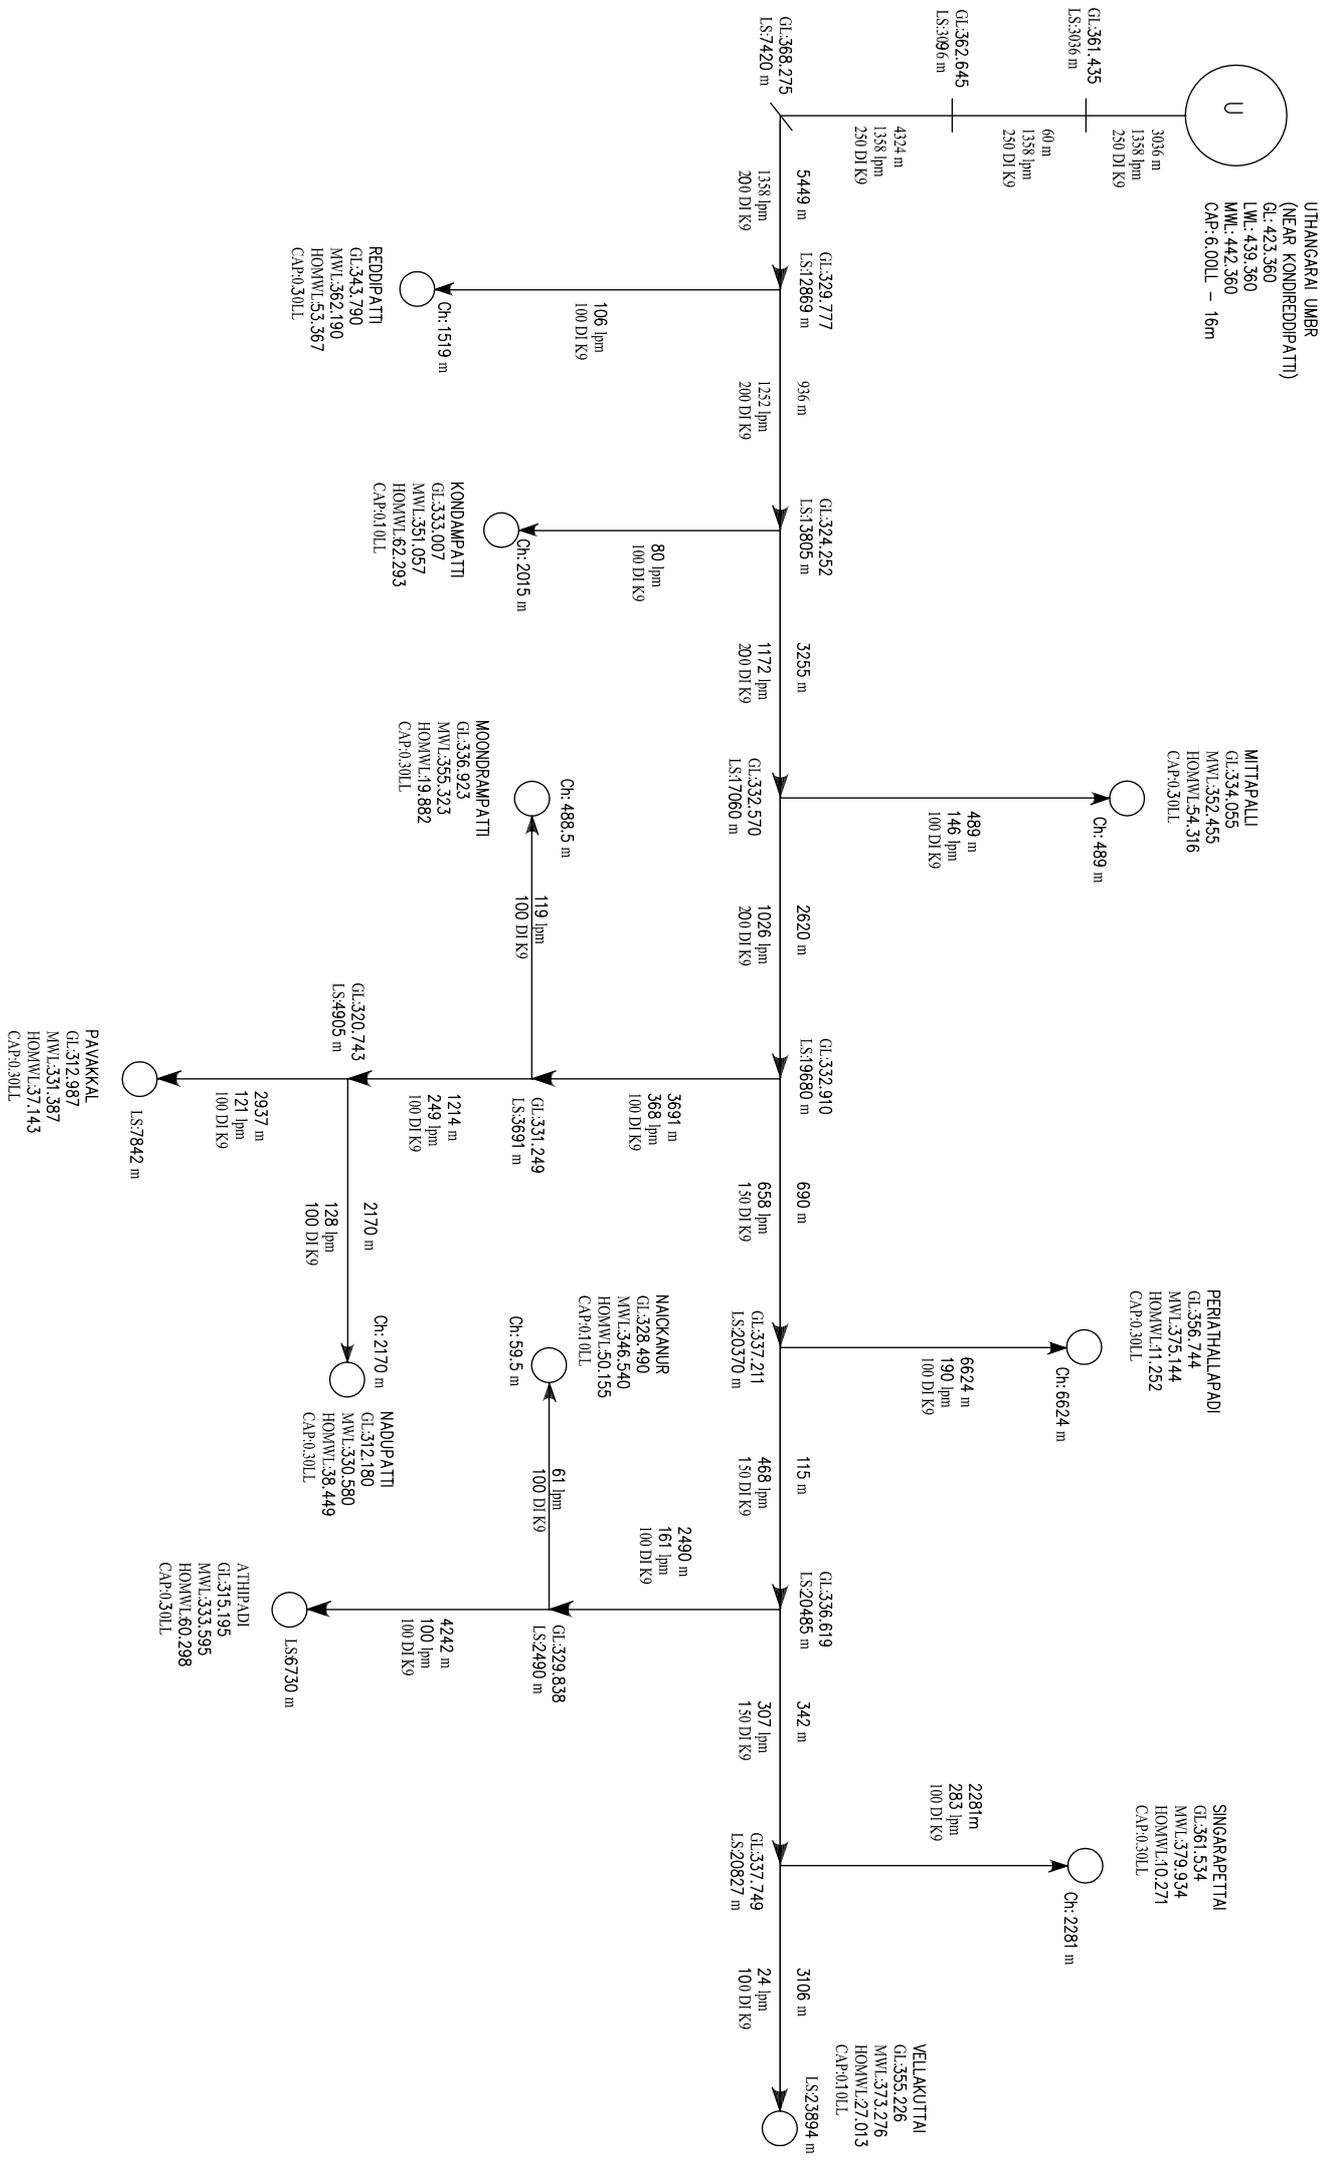

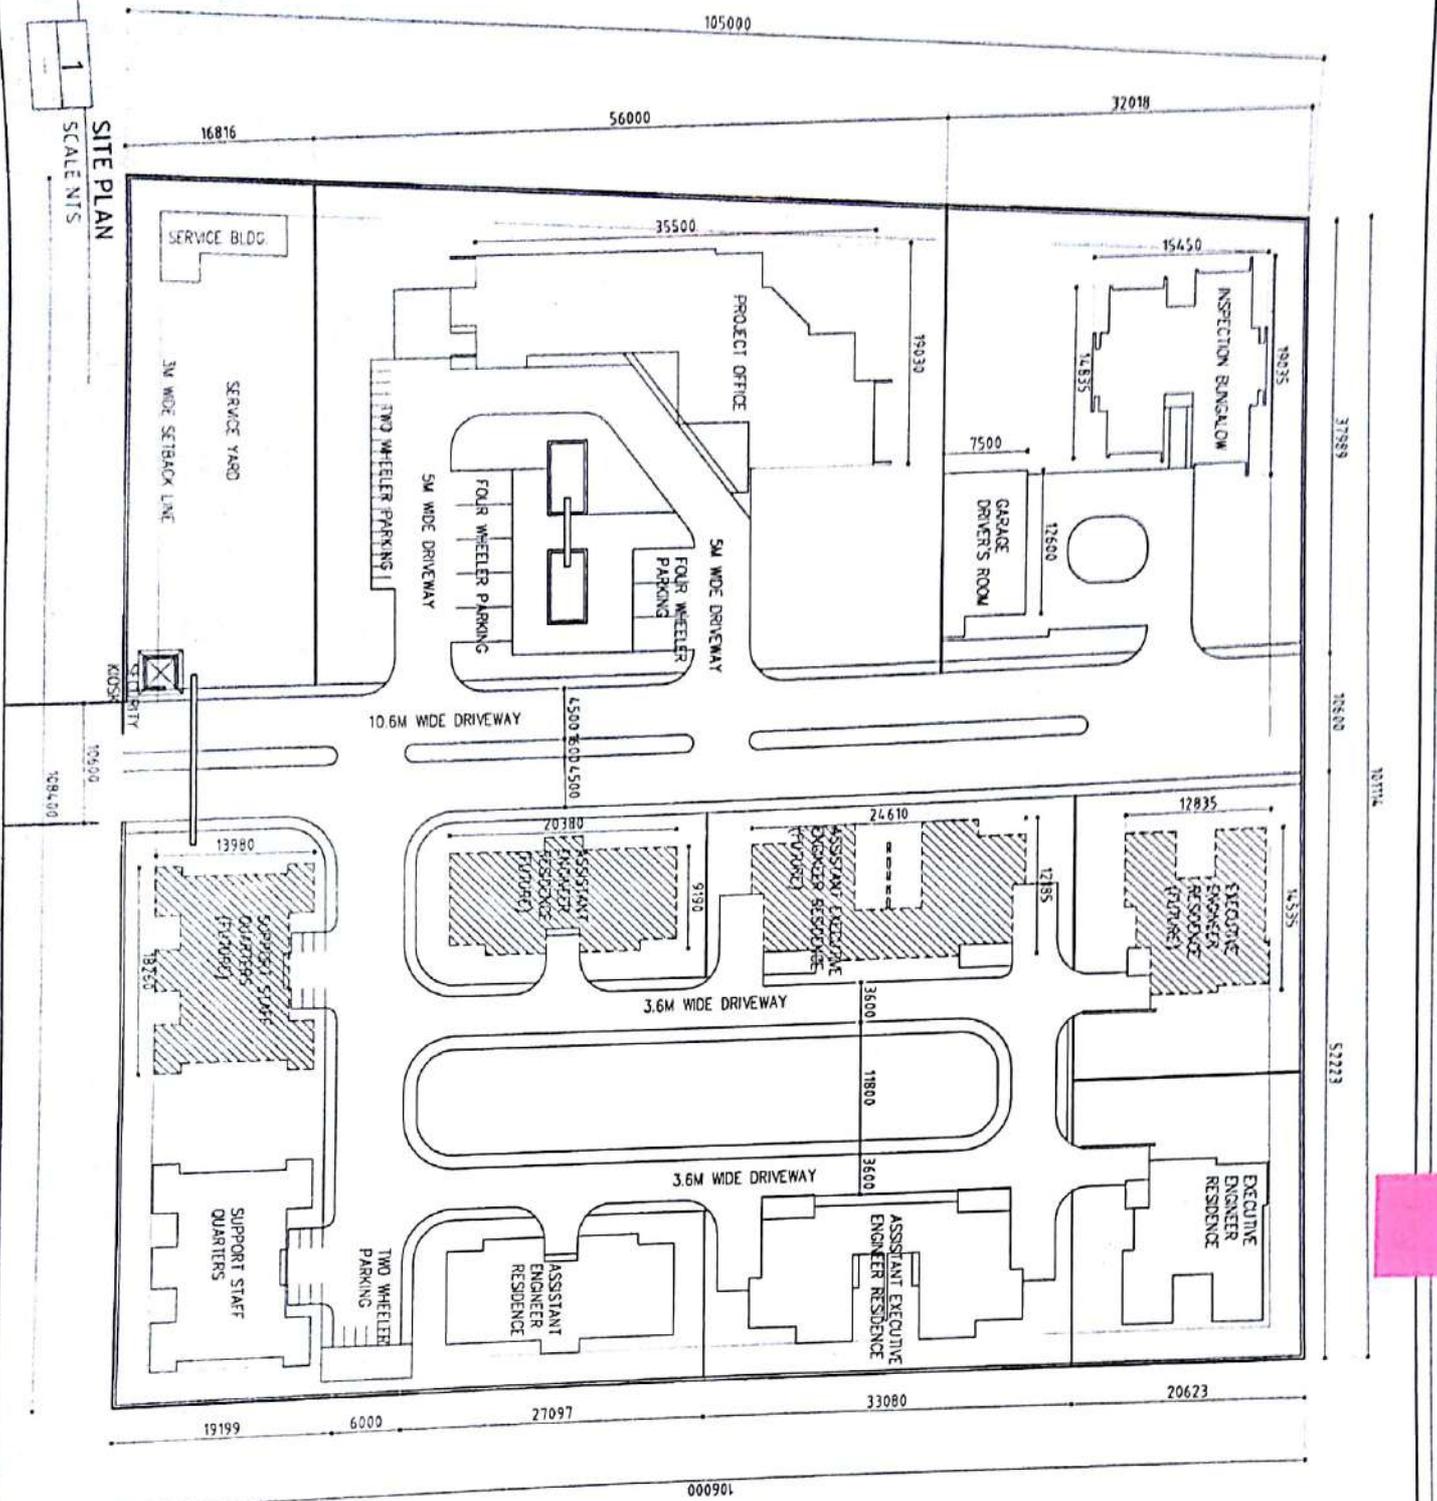

SITE PLAN
SCALE NTS

1

109500

109500

16816

35500

19030

7500

15450

12600

15335

12835

14535

12835

12835

56000

35500

19030

7500

15450

12600

15335

12835

14535

12835

12835

105000

35500

19030

7500

15450

12600

15335

12835

14535

12835

12835

37989

16800

52223

10714

10714

19199

6000

27097

33080

20623

19199

6000

27097

33080

20623

19199

6000

27097

33080

20623

19199

6000

27097

33080

20623

19199

6000

27097

100901

100901

